
FORM 51 10M 8-47

KANSAS Rice

Section 21 Township 18 Range 10W

Well No. #2 Bieberle

Company Murfin & Bishop
Orth Pool

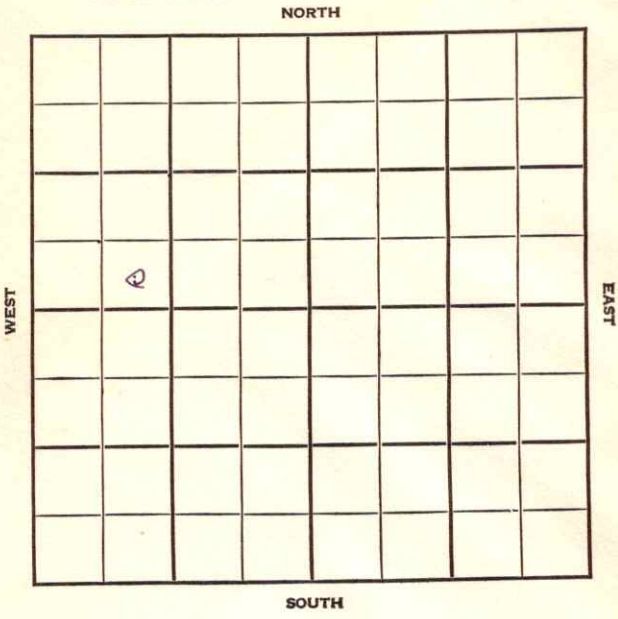

FORM 252-A
5M 12-45 PETROL


KANSAS Rice

Sec. 21 Twp. 18 R. 10W

Well No. #2 Bieberle Farm

Murfin & Bishop Company

Orth

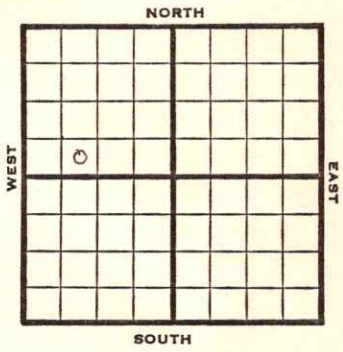

____ Ft. from N. Line

330 Ft. from S. Line

____ Ft. from E. Line

990 Ft. from W. Line

SE SW NW

1948	Elev. 1747' REPORT
4/14	Drlg. 150'
4/21	8" @ 319' Topeka 2550' Drlg. 2661'
4/28	"
5/5	Arbuckle 3230' 5" @ 3233' TD 3246' Swb. 2 bbls. oil PH
5/12	TD 3253' 1000 Acid Swb 7½ bbls oil PH
5/19	"
5/26	"
6/1	"
6/9	Arb. 3230' 5" @ 3233' 1000 acid Pump 210 Pot oil 41.0 Gr. TD 3253' Comp.

COMPLETED

Form 26—200 Bks.—1-48—Palace

Kansas

Orth Pool

Map No. _____ Sec. 21 Twp. 18 R. 10W


Well No. 2 Bieberle

Murfin & Bishop Company

FIRST REPORT Contractor

SE SW NW

SECTION PLAT

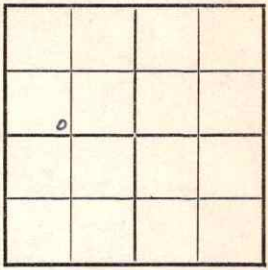

_____ Ft. from N. Line

330 Ft. from S. Line

_____ Ft. from E. Line

990 Ft. from W. Line

Rice County

Location _____

Rig up _____

Drilling and Remarks:

drlg. 150'

RECORD

Cased _____ in., _____ ft.

Sand _____

Gas _____

Oil _____

Total Depth _____

PRODUCTION

1st 24 hrs. Nat. _____

1st 24 hrs. after shot _____

Gas _____ Cu. Ft.

Dry Hole _____

Abandoned _____

Date

APR 1 4 1948 19____ S. J. LEWIS Scout

Form 26—200 Bks.—1-48—Palace

Kansas

Orth Pool

Map No. 55 Sec. 21 Twp. 18 R. 10W

Well No. 2 Bieberle


Murfin & Bishop Company

COMPLETE Contractor

SE SW NW

E1194?

SECTION PLAT

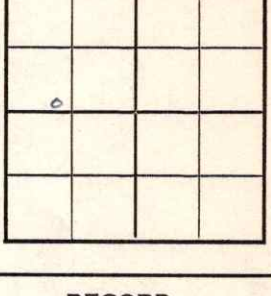

____ Ft. from N. Line

330 Ft. from S. Line

____ Ft. from E. Line

990 Ft. from W. Line

Rice County

Location

Rig up

Drilling and Remarks:

Ran 3230

5" @ 3233

100 sacks

Pump 210 Pet. Oil

41 ° Gr

RECORD

Cased ____ in., ____ ft.

Sand

Gas

Oil ✓

Total Depth 3253

PRODUCTION

1st 24 hrs. Nat.

1st 24 hrs. after shot

Gas ____ Cu. Ft.

Dry Hole

Abandoned

Date

JUN 9 1948

19 S. J. LEWIS Scout