

KANSAS

FORM 51 5M 1-42 PETROL

Russell

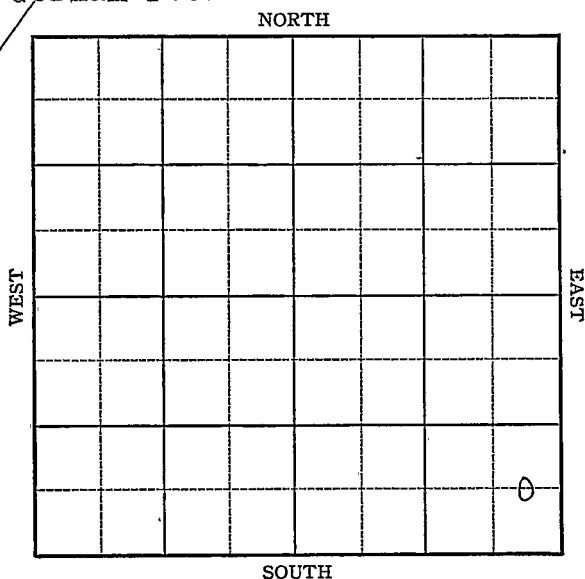
Section 9 Township 14 Range 15-W

2-1657022

Well No. #1 Furthmeyer

Company A. H. Witt

Gorham Pool

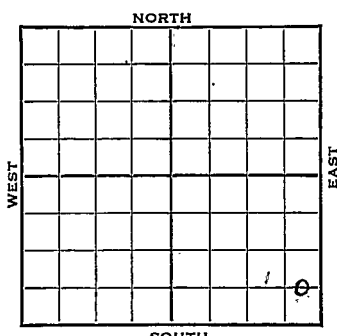


KANSAS

Russell

Sec. 9 Twp. 14 R. 15-WWell No. #1 Furthmeyer FarmA H Witt Company

Gorham Pool

 Ft. from N. Line660 Ft. from S. Line330 Ft. from E. Line Ft. from W. Line

C EL SE SE Elev. 1847

1942

REPORT

11/24	Cable
12/2	rig
12/8	"
12/16	18" @ 20'
	12" @ 585
	Drlg. 625
12/22	Anhy. 884
	10" @ 890'
	Drlg. 1695'
12/29	Drlg. 1870
1943	
1/6	8" Casing set at 2341
	Topeka 2730
	Drlg. 2815'
1/13	Dodge 2963
	5" casing set 2996'
	Lans 2998
	T.D. 3030'
	700' oil
1/20	" "
1/27	Lans 2998
	5" @ 2996'
	T.D. 3030'
	3000 gals acid
	Pump 470 Pot.
	Gravity 36

COMPLETED

Russell

KANSAS

Map No. 72 Sec. 9 Twp. 14 R. 15WWell No. 1 Furthmeyer

A. H. Witt

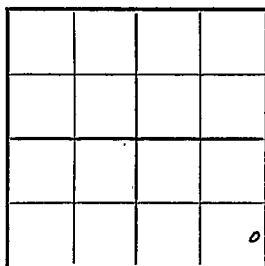
Company

FIRST REPORT

Contractor

C E L S E S E

SECTION PLAT

 Ft. from N. Line660 Ft. from S. Line330 Ft. from E. Line Ft. from W. Line

GORHAM POOL

Location Rig up

Drilling and Remarks:

Cable

RECORD

Cased in., ft.Sand Gas Oil Total Depth

PRODUCTION

1st 24 hrs. Nat. 1st 24 hrs. after shot Gas Cu. Ft.Dry Hole Abandoned

Date

NOV 24 1942

19

S. J. LEWIS

Scout

KANSAS

Map No. 72 Sec. 9 Twp. 14 R. 15WWell No. 1 Furthmeyer

A. H. Witt

Company

COMPLETED

Contractor

C E L S E S E

Ft. from N. Line

660 Ft. from S. Line330 Ft. from E. Line

Ft. from W. Line

SECTION PLAT

			0

GORHAM POOL

Location

Rig up

Drilling and Remarks:

*Lane 2998**5" @ 2996**3000 Acid**Pump 470 Pst.**36 2 Gr*

RECORD

Cased _____ in., _____ ft.

Sand _____

Gas _____

Oil _____

Total Depth 3030

PRODUCTION

1st 24 hrs. Nat. _____

1st 24 hrs. after shot _____

Gas _____ Cu. Ft.

Dry Hole _____

Abandoned _____

Date

JAN 27 1943

19

S. J. LEWIS Scout