


KANSAS

Rice

Section 21 Township 18 Range 10W

Well No. #2 - Apple

Company Bartlett & Crum

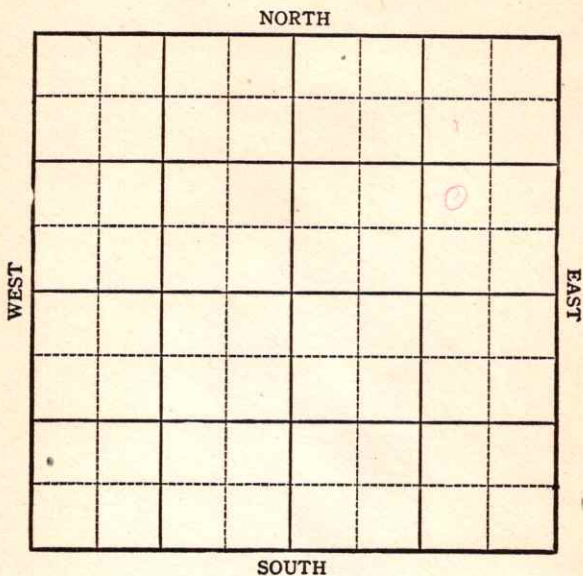

Sec. 21 Twp. 18 R. 10W

Well No. #2 Apple Farm

Bartlett & Crum Company

Chase


NORTH

_____ Ft. from N. Line

990 Ft. from S. Line

990 Ft. from E. Line

_____ Ft. from W. Line

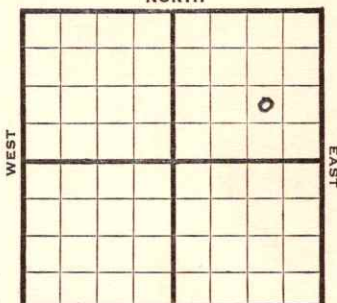

NW SE NE

Elev. 1742

SOUTH

1944

REPORT

- 8/9 Drk.
- 8/16 "
- 8/23 15" @ 65
- 12 " @ 450
- Anhy 462
- Drlg. 1075
- 8/30 10" @ 315
- Drlg. 1890
- 9/8 Drlg. 2630
- 9/13 2746' SD
- 9/21 " "
- 9/27 Arb 3252
- TD 3279
- HFW

ABANDONED

