


KANSAS Rice

Section 21 Township 18 Range 10-W

Well No. #2 Bieberle

Company Sohio & Derby^U rlg.
Orth

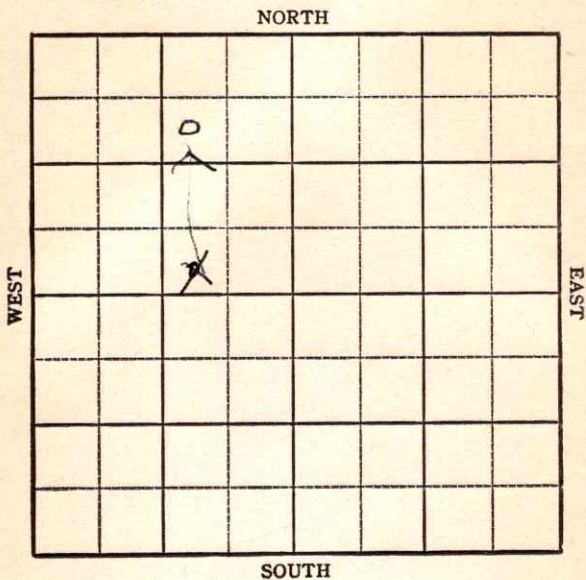

KANSAS

Rice ✓

Sec. 21 Twp. 18 R. 10W

Well No. #2 Bieberle Farm

Sohio & Derby Drlg. Company


Orth Pool

990 Ft. from N. Line

~~330~~ Ft. from S. Line

990 Ft. from E. Line

_____ Ft. from W. Line

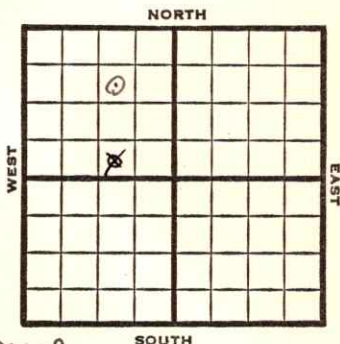

~~SW SE NW~~ *SW NE NW*

1948 **Elev. 1753'** REPORT

- 12/8 Surface Hole
- 12/15 8" @ 267'
- Drlg 2512'
- 12/22 **Topeka 2508'**
- Lansing 2912'**
- Arb. 3254-61'**
- TD 3261'
- 5" @ 3256'
- 12/29 "
- 1/5 15008 oil in 1 hr
- 1/12 "
- 1/19 "
- 1/26 **Arb. 3254'**
- 5" @ 3256'
- Pump 396 oil Pot.
- Gr. 41°
- TD 3261'

COMPLETED

Map No. _____ Sec. 21 Twp. 18 R. 10W

Well No. 2 Bieberle

Sohio & Derby Drlg. Company

FIRST REPORT Contractor

SW SE NW

SECTION PLAT

_____ Ft. from N. Line

330 Ft. from S. Line

990 Ft. from E. Line

_____ Ft. from W. Line

Rice County

Location _____

Rig up _____

Drilling and Remarks:

surface hole

RECORD

Cased _____ in., _____ ft.

Sand _____

Gas _____

Oil _____

Total Depth _____

PRODUCTION

1st 24 hrs. Nat. _____

1st 24 hrs. after shot _____

Gas _____ Cu. Ft.

Dry Hole _____

Abandoned _____

Date

DEC 8 1948

19

S. J. LEWIS

Scout

KALUCAS

Map No. 55 Sec. 21 Twp. 18 R. 10WWell No. 2 Bieberle

Sohio & Derby Drlg.

Company

CORRECTION

Contractor

SW NE NW

SECTION PLAT

990 Ft. from N. Line

Ft. from S. Line

990 Ft. from E. Line

Ft. from W. Line

	D		

Rice County

Location _____

Rig up _____

Drilling and Remarks:

Reported

SW SE NW

RECORD

Cased _____ in., _____ ft.

Sand _____

Gas _____

Oil _____

Total Depth _____

PRODUCTION

1st 24 hrs. Nat. _____

1st 24 hrs. after shot _____

Gas _____ Cu. Ft.

Dry Hole _____

Abandoned _____

Date

DEC 15 1948 19

S. J. LEWIS

Scout

Kansas

Map No. 55 Sec. 21 Twp. 18 R. 10WWell No. 2 Bieberle

Sohio & Derby Drlg. Company

COMPLETE

Contractor

SW NE NW

E. 1723

SECTION PLAT

990 Ft. from N. Line

_____ Ft. from S. Line

990 Ft. from E. Line

_____ Ft. from W. Line

Rice County

Location _____

Rig up _____

Drilling and Remarks:

*Cor 48254**5-10-208.**Prod 396 oil**4/2/49*

RECORD

Cased _____ in., _____ ft.

Sand _____

Gas _____

Oil Total Depth 261

PRODUCTION

1st 24 hrs. Nat. _____

1st 24 hrs. after shot _____

Gas _____ Cu. Ft.

Dry Hole _____

Abandoned _____

Date

JAN 26 1949

19

S. J. LEWIS

Scout