

Section 12 Township 14 Range 15W

Well No. 1 Boxberger

Company B ace Oil

NORTH

						2	

SOUTH

Sec. 12 Twp. 14 R. 15-W

Well No. #1 Boxberger Farm


Bace Oil Company

660 Ft. from N. Line

\_\_\_\_\_ Ft. from S. Line

990 Ft. from E. Line

~~990~~ Ft. from W. Line

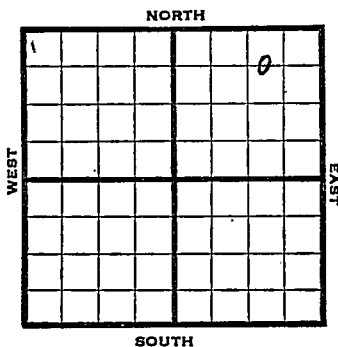

C WL NE NE

1945 Elev. 1864' REPORT

9/26 10" @ 280'  
Anhy. 680'  
Drlg. 2810'

10/3 " " "

10/10 Topeka 2715  
TD 2940  
7" @ 2931 RUST

10/17 500 acid.  
1/4 oil plus 3-3/4 WPH

10/24 Drlg. 3234

10/31 Arb. 3288  
TD 3288  
457' of 4" liner @ 3288 WOC

11/7 TD 3293  
700' oil drilling up some iron in the hole

11/14 TD 3295.  
800' oil

11/21 3288 Gotham corrected no Arb.  
TD 3295'

11/28 " " " "

12/5 " " " "

12/12 " " " "

12/20 " " " "

12/29 " " " "

OVER

**KANSAS**  
Kansas

Pool Name Big Creek

Map No. 72 Sec. 12 Twp. 14 R. 15W

Well No. 1 Boxberger

Base Oil Company

**FIRST REPORT**

Contractor

C WL NE NE


**SECTION PLAT**

660 Ft. from N. Line

         Ft. from S. Line

990 Ft. from E. Line

         Ft. from W. Line ✓

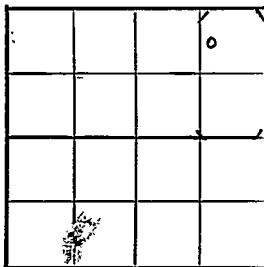

Russell County

Location                                 

Rig up 9/13

**Drilling and Remarks:**

10' - 280  
anhy 680  
2810

**RECORD**

Cased          in.,          ft.

Sand                                 

Gas                                 

Oil                                 

Total Depth                         

**PRODUCTION**

1st 24 hrs. Nat.                         

1st 24 hrs. after shot                         

Gas                          Cu. Ft.

Dry Hole                                 

Abandoned                                 

Date

SEP 26 1945 19

S. J. LEWIS Scout

Pool Name Big Creek

**KANSAS** Kansas

Map No. 72 Sec. 12 Twp. 14 R. 15W

Well No. 1 Boxberger

Base Oil \_\_\_\_\_ Company

**COMPLETED**

Contractor

C WL NE NE

E 1, 1864

**SECTION PLAT**

660 Ft. from N. Line

\_\_\_\_\_ Ft. from S. Line

990 Ft. from E. Line

\_\_\_\_\_ Ft. from W. Line

			o

**Russell County**

Location \_\_\_\_\_

Rig up \_\_\_\_\_

Drilling and Remarks:

*See log 3288*  
*7' @ 293'*  
*457 yd 4" wire*  
*Pump 34 P.D.*  
  
*(32)° SW*

**RECORD**

Cased \_\_\_\_\_ in., \_\_\_\_\_ ft.

Sand \_\_\_\_\_

Gas \_\_\_\_\_

Oil \_\_\_\_\_

Total Depth 3295'

**PRODUCTION**

1st 24 hrs. Nat. \_\_\_\_\_

1st 24 hrs. after shot \_\_\_\_\_

Gas \_\_\_\_\_ Cu. Ft.

Dry Hole \_\_\_\_\_

Abandoned \_\_\_\_\_

Date

JAN 9 1946 19

S. J. LEWIS Scout

1946

1/9

Gorham 3288

7" @ 2931

457' of 4" liner

TD 3295'

Pump 34 Pot1

Grav. 37.0

**COMPLETED**