

Map No. _____ Sec. 11 Twp. 27 R. 6
Well No. 1 Delta _____ Farm _____
John Phillips _____ Company _____

NORTH

WEST

EAST

SOUTH

Location -----

Drilling Remarks:

Rig Up-----

Drilling Remarks:

RECORD

Cased _____ in. _____ ft.

Sand_____

Gas _____

Oil _____

Total Depth -----

PRODUCTION

1st 24 hrs. Nat. -----

1st 24 hrs. after shot-----

Gas -----cu. ft.

Dry Hole_____

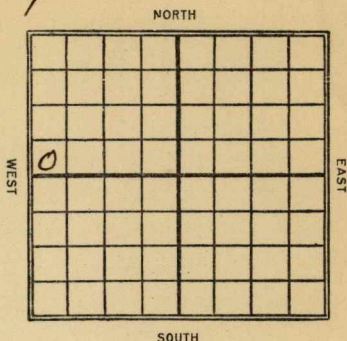
Abandoned_____

Map No. K Sec. 11 Twp. 27 R. 6Well No. 1 Diltz FarmJohn Phillips Company

Ft. from N. Line

200 Ft. from S. Line

Ft. from E. Line

200 Ft. from W. Line

Date

REPORT

192211/24Timbers12/13Dlg. 255 (2el)12/18✓ 640' (Letter)19231/26Abandoned 2810'

Map No. **KANSAS** Sec. **11** Twp. **27** R. **6**

Well No. **1**

Jahn P. Phillip Company

Contractor

FIRST REPORT

SECTION PLAT

----- Ft. from N. Line

200 Ft. from S. Line

----- Ft. from E. Line

200 Ft. from W. Line

o			

Location -----

Rig up -----

Drilling and Remarks:

Timbers.

RECORD

Cased ----- in., ----- ft.

Sand -----

Gas -----

Oil -----

Total Depth -----

PRODUCTION

1st 24 hrs. Nat. -----

1st 24 hrs. after shot -----

Gas ----- Cu. Ft.

Dry Hole -----

Abandoned -----

Date

M. A. BENEAR

NOV 24 1922

Scout

Map No. **KANSAS** Sec. **11** Twp. **27** R. **6**

Well No. **1401**

Jahn Phillips Company

Contractor

SPECIAL

SECTION PLAT

----- Ft. from N. Line

200 ----- Ft. from S. Line

----- Ft. from E. Line

200 ----- Ft. from W. Line

ABANDONED

Location -----

Rig up -----

Drilling and Remarks:

RECORD

Cased ----- in., ----- ft.

Sand -----

Gas -----

Oil -----

Total Depth -----

PRODUCTION

1st 24 hrs. Nat. -----

1st 24 hrs. after shot -----

Gas ----- Cu. Ft.

Dry Hole -----

Abandoned **2810'** -----

Date

JAN 26 1923

M. A. BENEAR

----- 191 ----- Scout