

Section 21 Township 14 Range 19-WWell No. 1 C. W. KrausCompany W. C. McBride Inc.

Kraus Pool

NORTH

							o

WEST

EAST

SOUTH

KANSAS

Ellis

Sec. 21 Twp. 14 R. 19N

Well No. #1 C. W. Kraus Farm

W. C. McBride, Inc. Company

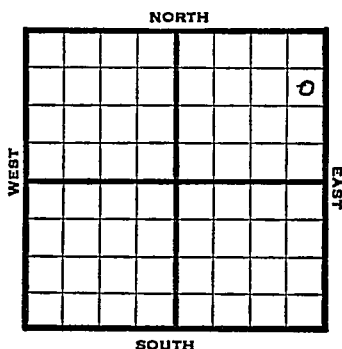
990 Ft. from N. Line

 Ft. from S. Line

330 Ft. from E. Line

 Ft. from W. Line

SE NE NE



1947

Elev. 2136 REPORT

9/24 Drlg. 460'

10/1 Drlg. 2915'

10/8 Arbuckle 3778'

TD 3830'

ABANDONED

Kraus Pool

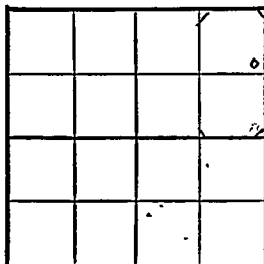
Form 26 200 Bks. 10-46 Petrol
Kansas

Kraus Pool

Map No. _____ Sec. 21 Twp. 14 R. 19WWell No. 1 C. W. KrausW. C. McBride Inc. CompanyFIRST REPORT Contractor

SE NE NE

SECTION PLAT

990 Ft. from N. Line Ft. from S. Line330 Ft. from E. Line Ft. from W. Line

Ellis County

Location _____

Rig up _____

Drilling and Remarks:

drlg. 460

RECORD

Cased _____ in., _____ ft.

Sand _____

Gas _____

Oil _____

Total Depth _____

PRODUCTION

1st 24 hrs. Nat. _____

1st 24 hrs. after shot _____

Gas _____ Cu. Ft.

Dry Hole _____

Abandoned _____

Date

SEP 24 1947 19

S. J. LEWIS Scout

Map No. 70 Sec. 21 Twp. 14 R. 19WWell No. 1 C. M. KrausM. C. McBride Inc. Company

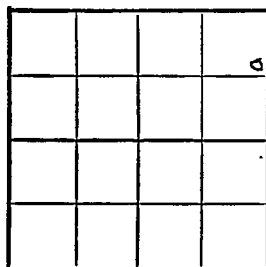
ABANDONED

Contractor

SE N^W NE

E. 2186.

SECTION PLAT

990 Ft. from N. Line Ft. from S. Line330 Ft. from E. Line Ft. from W. Line

Ellis County

Location Rig up

Drilling and Remarks:

Art 3778

RECORD

Cased in., ft.Sand Gas Oil Total Depth 2121

PRODUCTION

1st 24 hrs. Nat. 1st 24 hrs. after shot Gas Cu. Ft.Dry Hole Abandoned

Date

OCT 8 1947 19

S. J. LEWIS Scout