

Rice

KANSAS

Section 6 Township 18 Range 10-W

Well No. #2 Roesler "B" (Twin #1)

Company Transwestern et al


Bloomer Pool

NORTH

WEST

EAST

SOUTH

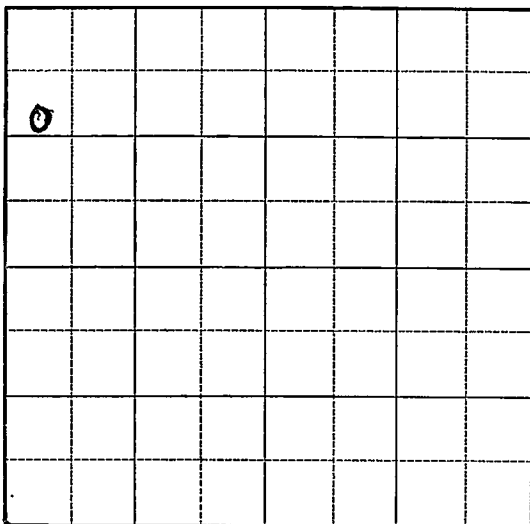

Rice

KANSAS

Map No. 55 Sec. 6 Twp. 18 R. 10WWell No. 2 Roesler "B" (Twin #1)Transwestern etal Company

Contractor

FIRST REPORT

SW NW NW

1035 Ft. from N. Line Ft. from S. Line Ft. from E. Line330 Ft. from W. Line

BLOOMER POOL

SECTION PLAT

o			

Location Rig up

Drilling and Remarks:

Lansing Test

RECORD

Cased in., ft.Sand Gas Oil Total Depth

PRODUCTION

1st 24 hrs. Nat. 1st 24 hrs. after shot Gas Cu. Ft.Dry Hole Abandoned

Date

AUG. 16 1939

19

S. J. LEWIS

Scout

Map No. _____ Sec. 6 Twp. 18 R. 10WWell No. 2 Roesler "B" (Twin #1)

Transwestern etal _____ Company

Contractor _____

COMPLETED

SW NW NW

1035 Ft. from N. Line

_____ Ft. from S. Line

_____ Ft. from E. Line

330 Ft. from W. Line**BLOOMER POOL****SECTION PLAT**

o			

Location _____

Rig up _____

Drilling and Remarks:

*Lane 2956.**5" C 3102.**Perforated 48 in to**2983-87**6000 acid**Flow 616 Psd***RECORD**

Cased _____ in., _____ ft.

Sand _____

Gas _____

Oil _____

Total Depth 3102**PRODUCTION**

1st 24 hrs. Nat. _____

1st 24 hrs. after shot _____

Gas _____ Cu. Ft.

Dry Hole _____

Abandoned _____

Date

SEP 10 1939 19**S. J. LEWIS**

Scout