


7. cons
broken
100 ft. floor.
Miss Wagner

Kansas
Woodson County
23-23-13
Atlantic Petroleum Corp.
Chris Bahr #16
1120' from N. line x 200' from W. line

23 Twp. 23 Rge. 13
Farm No.
Company
Elev. T. D.
Log No. 7962

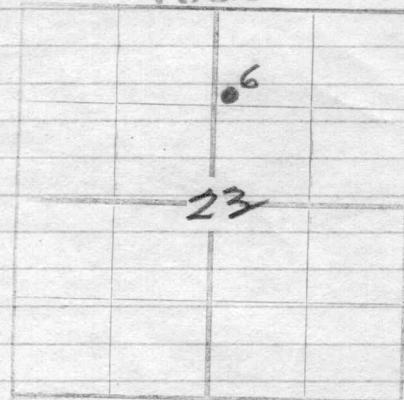

Soil - 8
shale - 30
L - 45
sh - 80
L - 96
red rock - 111
sh - 190
L - 205
sh - 700
S - 710 (S.B.W.)
L - 725
sh - 845
L - 885
sh - 900 (H.F.W.)
sandy L - 930
L - 945
sh - 960
red rock - 970
L - 1010
sh - 1270
L - 1290
sh - 1400
L - 1405
sl - 1658
S - 1690
sl - 1700 T.D.

Comm - July - 9 - 1922.
Fin - July - 28 - 1922.

- Logging Record -
12 - 1490
10 - 1050
8 1/4 - 1527
6 3/8 - 1590

ATLANTIC PETROLEUM CORPORATION.

" WELL RECORD. "

Well # 6, Chris Bahr. NE $\frac{1}{4}$ of Section 23-23-13 Greenwood County, Kansas.
 1120 Feet from the North Line, 200 Feet from West Line.
 Rig Commenced June 27, 1922. Rig Completed July 1, 1922.
 Rig Contractor Slater Brothers.
 Drilling Commenced July 9, 1922. Drilling Completed July 28, 1922.
 Contractor Patton Drilling Company.

Soil, Black Soft	8	
Shale, Blue Soft	30	
Lime, White Hard	45	
Shale, Blue Soft	80	
Lime, White Hard	96	
Red Rock, Red Soft	111	
Shale, Blue Soft	190	
Lime, White Hard	205	
Shale, Dark Soft	700	Set 12 $\frac{1}{2}$ " at 440' 11"
Sand, White Soft	710	5 Bailers of Water.
Lime, White Hard	725	
Shale, Dark Soft	845	
Lime, White Hard	885	
Shale, Blue Soft	900	Hole full of Water.
Sandy Lime, White Soft	930	
Lime, White Hard	945	
Shale, Blue Soft	960	
Red Rock, Red Soft	970	
Lime White Hard	1010	Set 10" at 1050' 5"
Shale, white soft	1270	
Lime, White Hard	1290	
Shale, White Soft	1400	
Lime, White Hard	1405	Set 8 $\frac{1}{4}$ " at 1527.
Slate, Black Soft	1658	
Bartlesville Sand, Brown	1690	Set 6-5/8" at 1590.
Slate	1700	Total Depth.

CASING RECORD.

12"	440'-11"	All Out.
10"	1050'-5"	Still In.
8 $\frac{1}{4}$ "	1527'	All Out.
6-5/8"	1590'	Still In.
2 In. Tubing	1692'-6"	

Pay Sand Top 1658' Bottom 1700' Feet of Sand 42' 100 Quarts 7-28-22.
 Total Depth 1700'
 Record of Sand and Oil Showing Oil.
 Production first 24 Hours -- 15 Barrels after shot 25 Barrels.
 Details of shot-- Between 1664' and 1690' 26' of 5 $\frac{1}{2}$ " Shell. 10' Anchor.