


Section 12 Township 18 Range 10W

Well No. #2 Habiger

Company Murfin Drlg & Saco Drlg

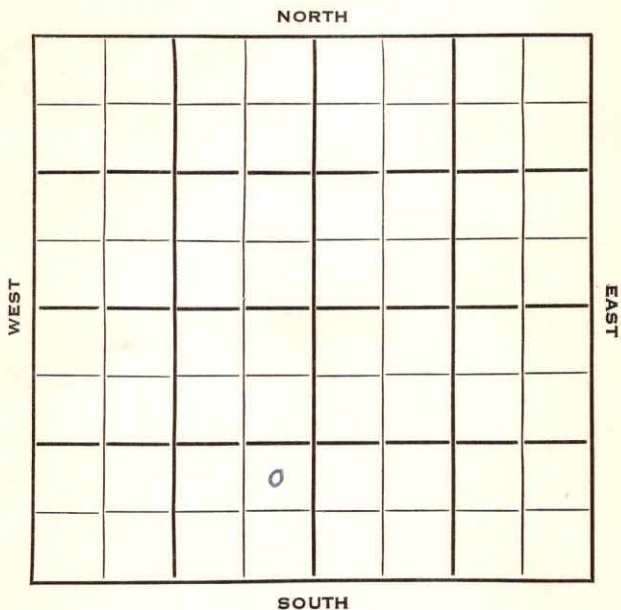

Rice

KANSAS



Sec. 12 Twp. 18 R. 10W

Well No. #2 Habiger Farm

Murfin Drlg. & Saco Drlg. Company

Murfin Drlg. Contractor

W Bredfeldt Pool


Ft. from N. Line

990 Ft. from S. Line

330 Ft. from E. Line

Ft. from W. Line

NE SE SW

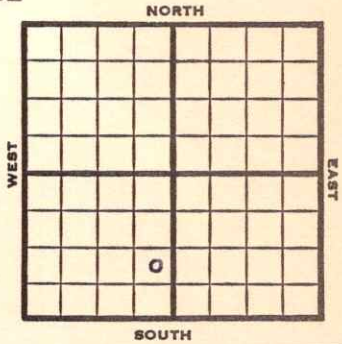

1953 Elev. 1750' REPORT

4/22 Spud 4-19-53  
8" @ 220, WOC

4/30 Heeb 2782' Br li 2900' Lans 2917'  
Drlg. 3220'

5/6 Spud 4-19-53  
D&A  
TD 3280  
8" @ 220  
Heeb 2782, Br lime 2900, Lans 2917  
DST 3267-73, opn 1 hr., rec. 10' mud  
O#  
Cong 3246, Arb. 3265  
TD 3280  
D&A

**ABANDONED**

County **Rice** State **Kansas**  
 Sec. **12** (Blk. Twp.) **18** (Sur. Rge.) **10W** Map No.  
 Operator **Murfin Drlg. & Saco Drlg.**  
 Well No. **2** Farm **Habiger**  
 Elev. \_\_\_\_\_ Location **NE SE SW**



**990** Ft. From **S** Line **SW**  
**330** Ft. From **E** Line **Quarter**

Ist. Report **APR 22 1953**

Completion \_\_\_\_\_

Remarks \_\_\_\_\_

**Murfin Drlg. - Contr.**

Spudding Date **4-19-53**

Drlg. Data \_\_\_\_\_

**W. Bredfeldt Pool**

**8" @ 220 WOC**

County Rice State Kansas  
 Sec. 12 (Blk.) 18 (Sur.) 10W Map No.  
 Operator Murfin Drlg. & Saco Drlg.  
 Well No. 2 Farm Habiger  
 Elev. 1750 Location NE SE SW



990 Ft. From S Line SW  
330 Ft. From E Line Quarter

1st. Report

Completion MAY 6 1953

Remarks W. Bredfeldt Pool  
Murfin Drlg. - Contr.

Spudding Date 4-19-53

Drlg. Data D & A TD 3280

8" @ 220 Heeb. 2782 Br. lime 2900

Lans. 2917 DST 3267-73 open 1 hr.

Rec. 10' mud O# Cong. 3246

Arb. 3265 TD 3280

D & A