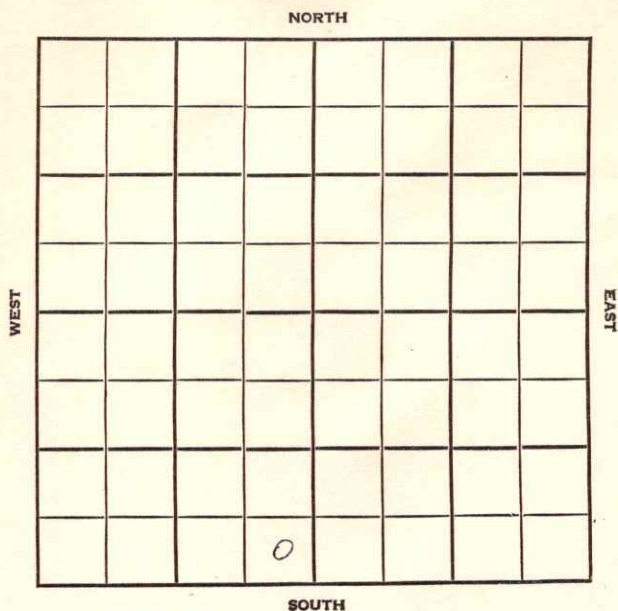


Section 14 Township 18S Range 10WWell No. #1 MehlCompany Jones, Shelburne & Farmer

Rice

KANSAS

SEC.

TWP.

R.

14

18S

10W

WELL NO.

#1 Mehl

FARM

COMPANY

Jones, Shelburne & Farmer

CONTRACTOR

Rig #4

Bushton


FT. FROM N. LINE

FT. FROM S. LINE

FT. FROM E. LINE

FT. FROM W. LINE

SE SE SW

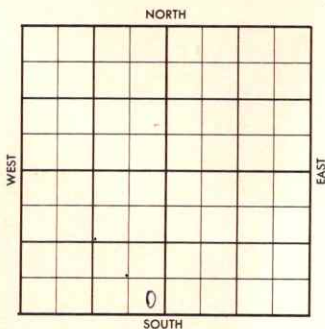

ELEVATION

1956

1754

REPORT

6-13

Location

7-3

Comm. 6-18-56

8 5/8" @ 160 w/115

DST 3266-78 op 90 min, rec. 145' OCM,
BHP 410/20".

D & A

Tp. 2529', H. 2792', BL. 2914',

L. 2940', BKG. 3203', Cherty 3247',

A. 3264'.

TD 3293'.

ABANDONED

County Rice Elev. _____
 Sec. 14 Twp. 18S Rge. 10W
 Company Jones, Shelburne & Farmer
 Farm Name Mehl No. 1

TOPS	DEPTH	LOG	DATUM	Loc. in Sec.
Anh.				SE SE SW
Tp.				
H.				
Tr.				
Dg.				
Bl.				
L.				Geol.
K.C.				Contr. rig #4
B.K.C.				
Ce.				
C.				
M.				Pool
M.				Bushton
K.				
Mz.				
Me.				
V.				
S.				
S.				
A.				
R.				
Pe.				
G.				
T.D.				

FIRST REPORT
 JUN 13 '56
 0

Date Comm. Loc.

TRIM S.O. 1956

R.G.

County Rice Elev. 1754
 Sec. 14 Twp. 18S Rge. 10W
 Company Jones, Shelburne & Farmer
 Farm Name Mehl No. 1

TOPS	DEPTH	LOG	DATUM	Loc. in Sec.
Anh.				SE SE SW
Tr.	2529			
H.	2792			
Tr.				
Dg.				
Bl.	2914			
L.	2940			
K.C.				Geol.
B.K.C.	3203			Contr. rig #1
Ce.				
C. <u>cherty</u>	3247			
M.				
M.				Pool
K.				Bushton
Mz.				
Ma.				
V.				
S.				
S.				
A.	3264			
R.				
Pe.				
G.				
T.D.	3293			

ABANDONED

JUL 3 1956

Date Comm. Loc. JUN 20 '56 6-18-56
 85/8 160/115 JUN 27 '56 2980
 JUL 3 '56 DST 3266-78 90" rec 145'
 OCM BHP 410/20"

D E A