


Rice

Map No. **KANSAS** Sec. 15 Twp. 18 R. 10 W

Well No. 1 Schmidt Farm
Slick Bryan & Lockhart Company

660 Ft. from N. Line
Ft. from S. Line
Ft. from E. Line
660 Ft. from W. Line

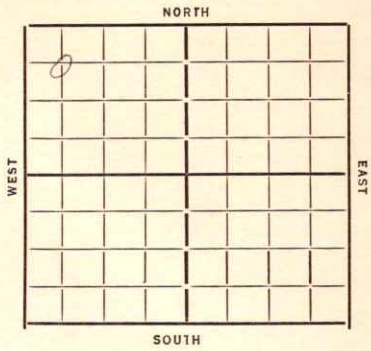

Date 1933

REPORT

12/27 Rig up
1/11
1/17 Dreg 400 20" at 140
1/24 " 1400
1/31 10" 1800 Dreg 2035
2/7 Dreg 2725
2/14 " 3112 Lansing 2949
2/23 " 3270 HFW 3140-45
6" 3153 5" 3263.
3/1 Conglomerate 3252 7D 3362
" 5"
3/8 Siliceous 3377 5" 3391
Dreg 3404
3/14 Siliceous 3377 7D 3503 Dr H

ABANDONED

Map No. 55 Sec. 15 Twp. 18 R. 10W

Well No. 1-Schmidt

Slick p + L Company

Contractor

ABANDONED

SECTION PLAT

660 Ft. from N. Line
 Ft. from S. Line
 Ft. from E. Line
660 Ft. from W. Line

0			

Location.....
 Rig up.....
 Drilling and Remarks:
W + A

RECORD

Cased..... in., ft.
 Sand silicious 3377
 Gas.....
 Oil.....
 Total Depth 3503

PRODUCTION

1st 24 hrs. Nat.....
 1st 24 hrs. after shot.....
 Gas..... Cu. Ft.
 Dry Hole.....
 Abandoned.....

Date 3-14-34 192 O. Mammuch Scout

Map No. 55 Sec. 15 Twp. 18 R. 10W

Well No. 1-Schmidt

Slick pyro & Eckhart Company

Contractor

FIRST REPORTS

SECTION PLAT

660 Ft. from N. Line

..... Ft. from S. Line

..... Ft. from E. Line

660 Ft. from W. Line

o			

Location.....

Rig up

Drilling and Remarks:

RECORD

Cased..... in., ft.

Sand.....

Gas.....

Oil.....

Total Depth.....

PRODUCTION

1st 24 hrs. Nat.....

1st 24 hrs. after shot.....

Gas..... Cu. Ft.

Dry Hole.....

Abandoned.....

Date

12-27-33 192 O. Mammersch Scout