

O.W.W.O.

FORM 51 25M 3-49 PETROL

Rice

KANSAS

Section 15 Township 18 Range 10W

Well No. #1 Schulz

Company Ash-Mur
~~Ash & Murfin~~

NORTH

WEST

EAST

							0

SOUTH

Sec. 15 Twp. 18 R. 10W

Well No. #1 Schulz Farm

~~Ash - Mur~~
~~Ash & Murfin~~

Company

Contractor

Orth Pool


990' Ft. from N. Line

_____ Ft. from S. Line

330' Ft. from E. Line

_____ Ft. from W. Line

SE NE NE

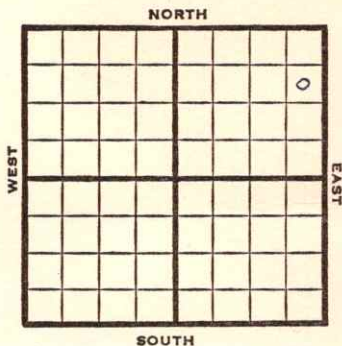

1950

Elev 1768

REPORT

8/30 Spud 8-20-50

8-5/8" @ 191'

Anhy 478-98'

Drlg. 2246'

9/13 8 5/8" @ 191

Anhy 478-98

Br lime 2923

B KC 3208

Arb 3273-98

TD 3298

D&A

Heeb 2793

Lans 2938

Ch cong 3263

ABANDONED

1952

O.W.W.O.

6/4

Lans. 2938' Cong 3263' Arb. 3273'

OTD 3298' CO to TD Rng 5".

6/11

NR

6/18

CO 3298 S/1 BOPH 1000 A went behind pipe Sq shoe

6/25

DP 3300' 500 A S/1 BOPH POP

7/2

25 BOPD

7/9

NR

7/17

"

7/23

"

7/30

"

8/6

"

8/13

"

OVER

1952

8/20

D&A TD 3300

Lans. 2938 Cong. 3263


Arb. 3273 OTD 3298

5" @ 3277 CO to 3298

S/l boph 1000 A DP to 3300

500 A S/l boph 25 bopd D&A

ABANDONED

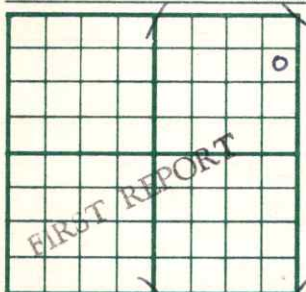County Rice State KansasSec. 15 (Blk. Twp.) 18 (Sur. Rge.) 10W Map No.Operator Ash & MurfinWell No. 1 Farm SchulzElev. _____ Location SE NE NE990 Ft. From N Line NE330 Ft. From E Line Quarter1st. Report AUG 30 1950

Completion _____

Remarks _____

Spudding Date 8-20-50Drlg. Data Orth Pool8 5/8" @ 191 Anhy 478-98 drlg. 2246

J. E. TYRA

County Rice State KansasSec. 15 (Blk.
Twp.) 18 (Sur.
Rge.) 10W Map No.Operator Ash & MurfinWell No. 1 Farm SchulzElev. 1768 Location SE NE NE990 Ft. From N Line NE330 Ft. From E Line Quarter

1st. Report

Completion SEP 13 1950

Remarks

Orth PoolSpudding Date 8-20-50Drlg. Data D & A TD 32988 5/8" @ 191 Anhy 478-98 Heeb. 2793Br. lime 2923 Lans. 2938 B KC 3208Ch. Cong. 3263 Arb. 3273-98 TD 3298D & A

J. E. TYRA

County Rice State Kansas
 Sec. 15 (Blk. 18 (Sur. 10W Map No.
 (Twp.) (Rge.)
 Operator Ash-Mur (was Ash & Murfin)
 Well No. 1 Farm Schulz
 Elev. 1768 Location SE NE NE



990 Ft. From N Line NE

330 Ft. From E Line Quarter

1st. Report

Completion AUG 20 1952

Remarks OWWO

Spudding Date

Drlg. Data D & A TD 3300

Lans. 2938 Cong. 3263 Arb. 3273

OTD 3298 5" @ 3277 CO to 3298

S/ 1 boph 1000 A DP to 3300 500 A

S/ 1 boph 25 bopd

D & A