


Kansas

Map No. _____ Sec. 23 Twp. 23 R. 13Well No. 6 - Bahr FarmAtlantic Pet. Company

NORTH

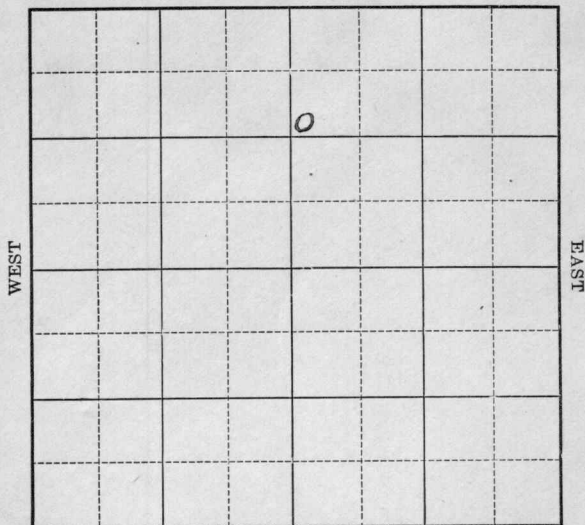

SOUTH

COMPLETED

Location _____

Drilling Remarks:

Rig Up _____

Drilling Remarks:

RECORD

Cased _____ in. _____ ft.

Sand _____

Gas _____

Oil _____

Total Depth _____

PRODUCTION

1st 24 hrs. Nat. _____

1st 24 hrs. after shot _____

Gas _____ cu. ft.


Dry Hole _____

Abandoned _____

Map No. _____ Sec. 23 Twp. 23 R. 13Well No. #6 B&H Farm _____
Atlantic Pet Company1120 Ft. from N. Line

_____ Ft. from S. Line

_____ Ft. from E. Line

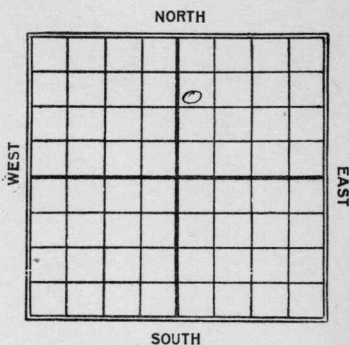200 Ft. from W. Line

Date

1922

REPORT

7/22

Dy 750'

8/13

Dd 1658-1700

Shot 100 gts

75 Bbls

Map No. Kanso 17 Sec. 23 Twp. 23 R. 13Well No. 6 - BakerAtlantic Pet Company

Contractor

FIRST REPORT

1120 Ft. from N. Line

Ft. from S. Line

Ft. from E. Line

200 Ft. from W. Line

SECTION PLAT

		0	

Location

Rig up

Drilling and Remarks:

750'

RECORD

Cased _____ in., _____ ft.

Sand _____

Gas _____

Oil _____

Total Depth _____

PRODUCTION

1st 24 hrs. Nat. _____

1st 24 hrs. after shot _____

Gas _____ Cu. Ft.

Dry Hole _____

Abandoned _____

Date

JUL 22 1912

191

BENEAR

Scout

Map No. San 17 Sec. 23 Twp. 23 R. 13Well No. 6 Baker
Atlantic Pet. Company

Contractor

COMPLETED

SECTION PLAT

1120' Ft. from N. Line

Ft. from S. Line

Ft. from E. Line

200' Ft. from W. Line

		0	

Location

Rig up

Drilling and Remarks:

Shot 100 ft

RECORD

Cased _____ in., _____ ft.

Sand 1658-1700

Gas _____

Oil _____

Total Depth 1700

PRODUCTION

1st 24 hrs. Nat. _____

1st 24 hrs. after shot 75

Gas _____ Cu. Ft.

Dry Hole _____

Abandoned _____

Date

AUG 13 1922

M. A. BENEAR

191

Scour