


Kansas
Woodson County
Atlantic Pet. Corp.
Chris Baker #7
23-23-13
N.E. 1/4

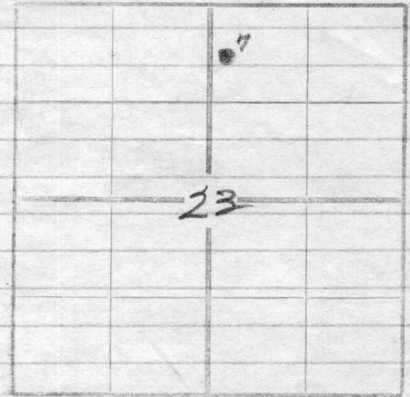

Com - 1-6-1923

Fin - 1-31-1923

-Coring Record-

12 1/2' - 439'

10" - 1049'

8 1/4" - 1399'

6 5/8" - 1767'

sil- 5
 L- 15
 sl- 65
 L- 75
 sl- 150
 L- 165
 sl- 430
 L- 440
 sl- 710
 L- 740
 sl- 770
 L- 790
 sl- 850
 L- 890
 sl- 915 (water) (H.F.M.)
 L- 950
 sl- 975
 R.R- 980
 sl- 990
 L- 1020
 sl- 1032 (water)
 L- 1125
 sl- 1260
 L- 1280
 sl- 1355
 L- 1365
 sl- 1387
 L- 1392
 sl- 1400
 ody L- 1425
 L- 1450
 sl- 1619
 sl- 1628
 sl- 1638
 sl & sh- 1692
 sl- 1762
 L- 1789
 broken L- 1799 Pay Sand.
 L- 1805 T.D.

Geol. Dept.

NE 1/4 Sec. 23-23-13 Woodson, Kns.
660' from N. & 200' from West

WELL RECORD, CHRIS BAHR #7

Drilled by Atlantic Petroleum Corporation.
Drilling Commenced January 6, 1923.

Drilling Completed Jan. 31, '23

<u>Formation.</u>	<u>From.</u>	<u>To.</u>	<u>Remarks.</u>
Soil, black soft	0	5	
Lime, white hard	5	15	
Slate, blue soft	15	65	
Lime, white hard	65	75	
Slate, blue soft	75	150	
Lime, white hard	150	165	
Slate, blue soft	165	430	
Lime, white hard	430	440	Set 12 $\frac{1}{2}$ " Csg. @ 439' 3"
Slate, blue soft	440	710	
Lime, white hard	710	740	
Slate, blue soft	740	770	
Lime, white hard	770	790	
Slate, blue soft	790	850	
Lime, white hard	850	890	
Sand, white soft, water	890	915	Hole full of water.
Lime, white hard	915	950	
Slate, blue soft	950	975	
Red rock, red soft	975	980	
Slate, white soft	980	990	
Lime, white hard	990	1020	
Water sand, white soft	1020	1032	
Lime, white hard	1032	1125	Set 10" Csg. @ 1049' 6"
Shale, blue soft	1125	1260	
Lime, white hard	1260	1280	
Slate, blue soft	1280	1355	
Lime, white hard	1355	1365	
Shale, dark soft	1365	1387	
Lime, white hard	1387	1392	Set 8 $\frac{1}{4}$ "
Slate, blue soft	1392	1400	
Sandy lime, white hard	1400	1425	
Lime, white hard	1425	1450	
Slate, blue soft	1450	1619	Set 6-5/8" Csg. @ 1619'
Sand, oily hard	1619	1628	Show of oil.
Shale, blue soft	1628	1638	Csg. Pulled. hole S. Reamed
Sand & Shale, light soft	1638	1692	Set 6-5/8" Csg. @ 1767'
Slate, light soft	1692	1762	
Lime, white hard	1762	1789	
Broken sand, light soft	1789	1799	Pay sand. shot 40 quarts.
Lime, white hard	1799	1805	Total Depth.

Initial Production 80 Barrels.

CASING RECORD.

<u>PUT IN.</u>	<u>PULLED OUT.</u>	<u>LEFT IN.</u>
12 $\frac{1}{2}$ " 50# 439' 3"	137' 4"	301' 11"
10" 35# 1049' 6"	1049' 6"	
8 $\frac{1}{4}$ " 28# 1399' 2"		1399' 2"
6-5/8" 20# 1767' 6"		1767' 6"
2" tubing 4 $\frac{1}{2}$ # 84 Joints.		
71 3/4" rods 1775'		