

WEST

EAST

SOUTH

Drilling Remarks:

Drilling Remarks:


Cased _____ in. _____ ft.
 Sand _____
 Gas _____
 Oil _____
 Total Depth _____

1st 24 hrs. Nat.-----
1st 24 hrs. after shot-----
Gas-----cu. ft
Dry Hole-----
Abandoned -----

Map No. K-11 Sec. 13 Twp. 27 R. 6
 Well No. 1 Stabbing Farm
Central Oil Co Company

NORTH

WEST

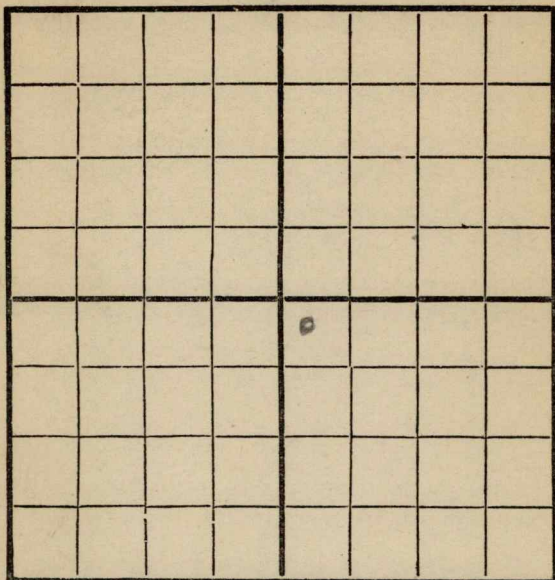

EAST

SOUTH

Location ✓Rig Up ✓

Drilling and remarks

FIRST REPORT

RECORD

Cased _____ in. _____ Ft.

Sand _____

Gas _____

Oil _____

Total Depth _____

PRODUCTION

1st 24 hrs. Nat. _____

1st 24 hrs. after shot _____

Gas _____ Cu. Ft.

Dry Hole _____

Abandoned _____

Date


6/12, 1917, C. C. C. C. Scout

Map No. _____ Sec. 13 Twp. 27 R. 6
 Well No. 1 sketching Farm _____
Central oil Company _____

NORTH

WEST

EAST

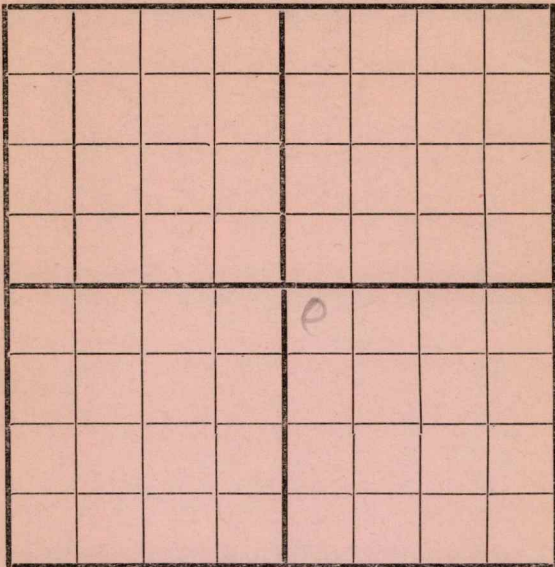

SOUTH

Location _____
 Rig Up _____
 Drilling and remarks _____

RECORD

Cased _____ in. _____ Ft.
 Sand _____
 Gas _____
 Oil _____
 Total Depth _____

PRODUCTION


1st 24 hrs. Nat. _____
 1st 24 hrs. after shot _____
 Gas _____ Cu. Ft.
 Dry Hole _____
 Abandoned _____

Date 6/30, 1912 Condy Scout

Map No. _____ Sec. 13 Twp. 27 R. 6Well No. Shelton Farm _____Central Oil Company _____

NORTH

WEST

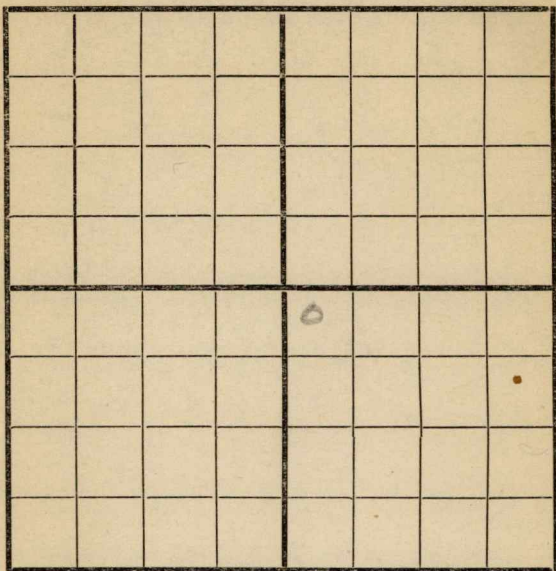

EAST

SOUTH

Location _____

Rig Up ✓ _____

Drilling and remarks _____

RECORD

Cased _____ in. _____ Ft.

Sand _____

Gas _____

Oil _____

Total Depth _____

PRODUCTION

1st 24 hrs. Nat. _____

1st 24 hrs. after shot _____

Gas _____ Cu. Ft.

Dry Hole _____

Abandoned _____

Date

6/27 1917 Condiff Scout

Map No. _____ Sec. 13 Twp. 27 R. 6

Well No. 1200 Farm _____

_____ Company

NORTH

WEST

EAST

SOUTH

Location _____

Rig Up-----

Drilling and remarks

RECORD

Cased-----in. -----Ft.

Sand.....

Gas _____

Oil-----

Total Depth_____

PRODUCTION

1st 24 hrs. Nat.

1st 24 hrs. after shot-----

Gas_____ Cu. Ft.

Dry Hole_____

Abandoned_____

Date _____


2/6, 1912. *Pauline* Scout

Scout

Map No. _____ Sec. 13 Twp. 27 R. 6Well No. 1 Stebbins Farm _____Central Oil Co Company _____

NORTH

WEST

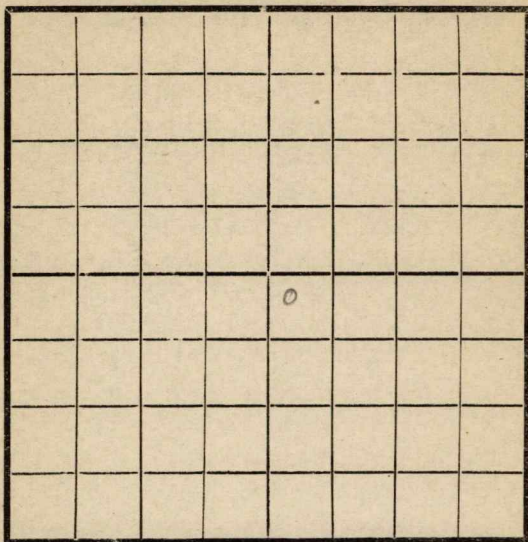

EAST

SOUTH

RECORD

Location _____

Cased _____ in. _____ Ft.

Rig Up _____

Sand _____

Drilling and remarks

Gas _____

Oil _____

Total Depth _____

PRODUCTION

1st 24 hrs. Nat. _____

1st 24 hrs. after shot _____

Gas _____ Cu. Ft.

Dry Hole _____

Abandoned _____

Date


7/11, 1917 Carly Scout

Map No. _____ Sec. 13 Twp. 22 R. 6Well No. 1 Stebbins Farm _____

Company _____

NORTH

WEST

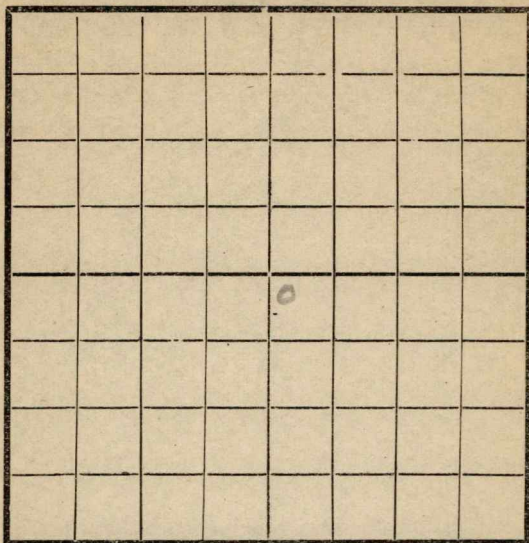

EAST

SOUTH

Location _____

Rig Up _____

Drilling and remarks

22250
for mtn

RECORD

Cased _____ in. _____ Ft.

Sand _____

Gas _____

Oil _____

Total Depth _____

PRODUCTION

1st 24 hrs. Nat. _____

1st 24 hrs. after shot _____

Gas _____ Cu. Ft.

Dry Hole _____

Abandoned _____


Date

7/17, 1917 Condy Scout

Map No. _____ Sec. 13 Twp. 27 R. 6Well No. 1 Stebbins FarmCentral O & G Company

NORTH

WEST

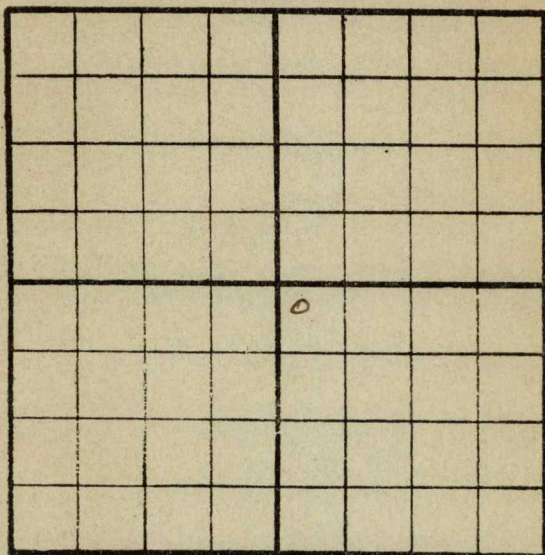

EAST

SOUTH

Location _____

Rig up _____

Drilling and remarks:

400'

RECORD

Cased _____ in. _____ Ft.

Sand _____

Gas _____

Oil _____

Total Depth _____

PRODUCTION

1st. 24 hrs. Nat. _____

1st. 24 hrs. after shot. _____

Gas _____ Cu. Ft.

Dry Hole _____

Abandoned _____

Date

7/27 1917 Condeff Scout

Map No. _____ Sec. 13 Twp. 27 R. 6

Well No. 1 Stebbins Farm _____
Centerville Company

NORTH

WEST

EAST

SOUTH

RECORD

Location _____

Rig up _____

Drilling and Remarks:

900'

Cased _____ in. _____ Ft.

Sand _____

Gas _____

Oil _____

Total Depth _____

PRODUCTION

1st 24 hrs. Nat. _____

1st 24 hrs. after shot _____

Gas _____ Cu. Ft.

Dry Hole _____

Abandoned _____

Date

8/1, 1917, Centerville Scout

Map No. _____ Sec. 13 Twp. 27 R. 6Well No. 1 Stebbins FarmCentral Oil & Gas Company

NORTH

WEST

EAST

SOUTH

RECORD

Location _____

Cased _____ in. _____ Ft.

Rig Up _____

Sand _____

Drilling and remarks

Gas _____

Oil _____

Total Depth _____

PRODUCTION

1st 24 hrs. Nat. _____

1st 24 hrs. after shot _____

Gas _____ Cu. Ft.

Dry Hole _____

Abandoned _____

Date


8/18, 1917 Conley Scout

Map No. K 11 Sec. 13 Twp. 27 R. 6Well No. 1. Stebbins FarmCentral Oil & Gas Company

NORTH

WEST

EAST

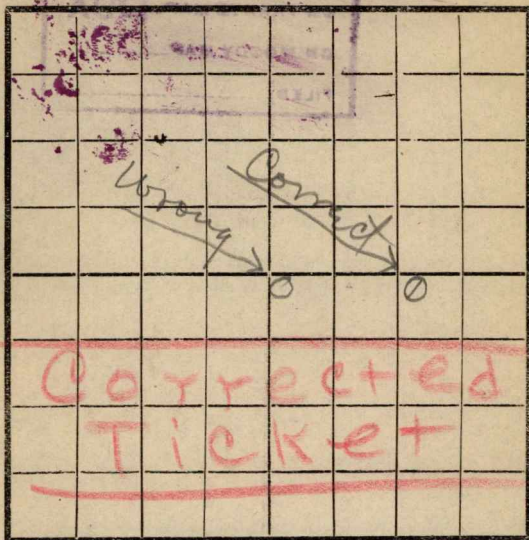

SOUTH

RECORD

Location -----

Cased ----- in. ----- Ft.

Rig Up -----

Sand -----

Drilling and remarks

Gas -----

Fishing for
Bit at 835.

Oil -----

Total Depth -----

PRODUCTION

1st 24 hrs. Nat. -----

1st 24 hrs. after shot -----

Gas ----- Cu. Ft.

Dry Hole -----

Abandoned -----


Date

8-21, 1917 Lantz Scout

Map No. _____ Sec. 13 Twp. 27 R. 6Well No. 1 Steadman Farm _____Central Oil & Gas Company

NORTH

WEST

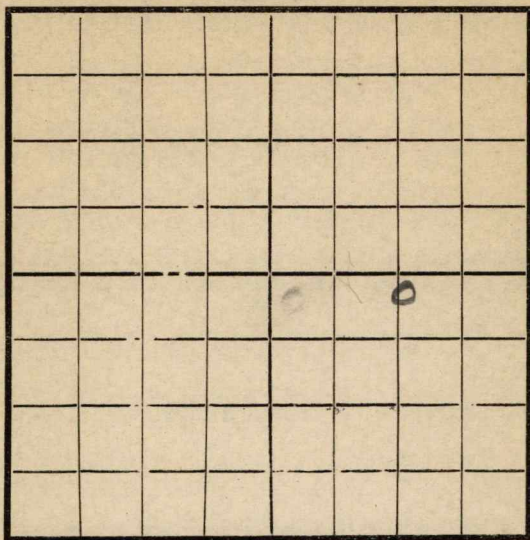

EAST

SOUTH

RECORD

Location _____

Cased _____ in. _____ Ft.

Rig Up _____

Sand _____

Drilling and remarks

Gas _____

Oil _____

Total Depth _____

PRODUCTION

1st 24 hrs. Nat. _____

1st 24 hrs. after shot _____

Gas _____ Cu. Ft.

Dry Hole _____

Abandoned _____


Date

9/5, 1917 Central Scout

Map No. _____ Sec. 13 Twp. 27 R. 6
 Well No. 1 Stubbins Farm _____
Central O & G Company _____

NORTH

WEST

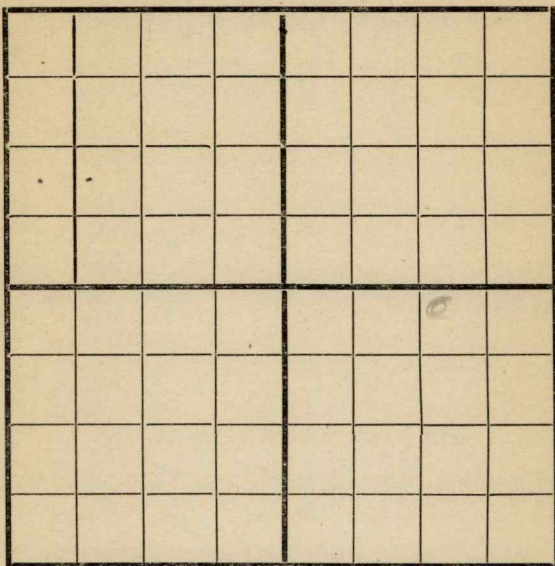

EAST

SOUTH

RECORD

Location _____

Cased _____ in. _____ Ft.

Rig Up _____

Sand _____

Drilling and remarks

Gas _____

*Skidded
Rig*

Oil _____

Total Depth _____

PRODUCTION

1st 24 hrs. Nat. _____

1st 24 hrs. after shot _____

Gas _____ Cu. Ft.

Dry Hole _____


Abandoned _____

Date

9/12 1917 Carbide Scout

Map No. _____ Sec. 13 Twp. 22 R. 6
 Well No. 1 Stebbins Farm _____
Century Oil & Gas Company

NORTH

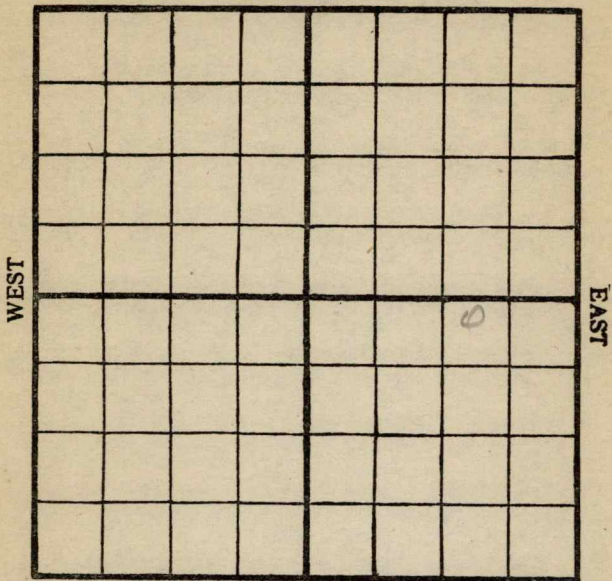

SOUTH

Location _____

Rig Up _____

Drilling and remarks

820.

RECORD

Cased _____ in. _____ Ft.

Sand _____

Gas _____

Oil _____

Total Depth _____

PRODUCTION

1st 24 hrs. Nat. _____

1st 24 hrs. after shot _____

Gas _____ Cu. Ft.

Dry Hole _____

Abandoned _____

Date


9/9, 1917Condy Scout


Company _____

NORTH

WEST

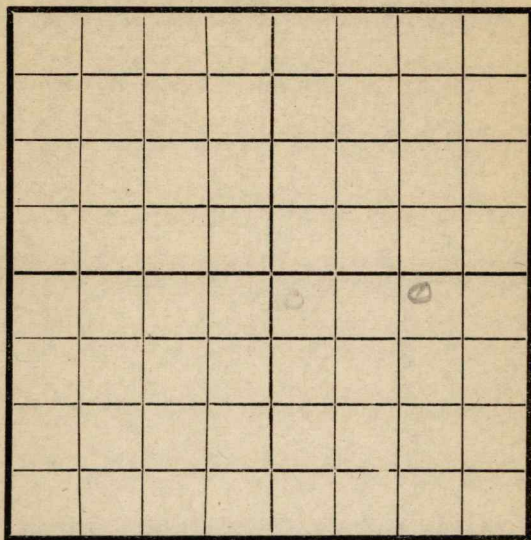

EAST

SOUTH

Location _____

Rig Up _____

Drilling and remarks

830

RECORD

Cased _____ in. _____ Ft.

Sand _____

Gas _____

Oil _____

Total Depth _____

PRODUCTION

1st 24 hrs. Nat. _____

1st 24 hrs. after shot _____

Gas _____ Cu. Ft.

Dry Hole _____

Abandoned _____

Date

9/27, 1917 C. D. J. Scout

Map No. _____ Sec. 13 Twp. 22 R. 6


Well No. 1500 Farm _____

Central Company _____

NORTH

WEST

EAST

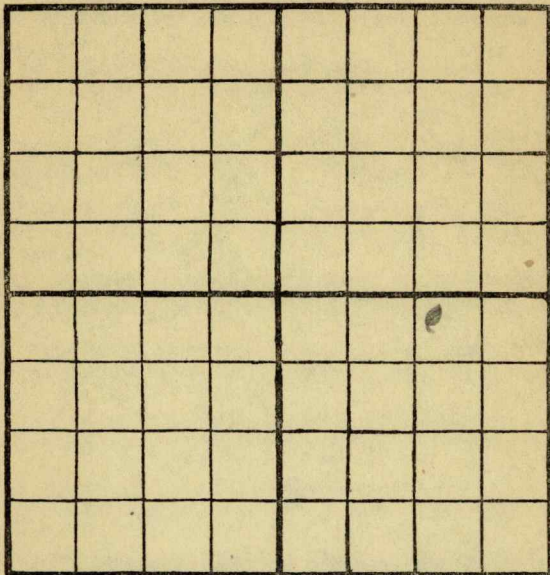

SOUTH

Location _____

Rig Up _____

Drilling and remarks

1050

RECORD

Cased _____ in. _____ Ft.

Sand _____

Gas _____

Oil _____

Total Depth _____

PRODUCTION

1st 24 hrs. Nat. _____

1st 24 hrs. after shot _____

Gas _____ Cu. Ft.

Dry Hole _____

Abandoned _____


Date

10/27, 1917, Landry Scout

Map No. _____ Sec. 13 Twp. 27 R. 6Well No. 1 Seebing Farm _____Company Centrop

NORTH

WEST

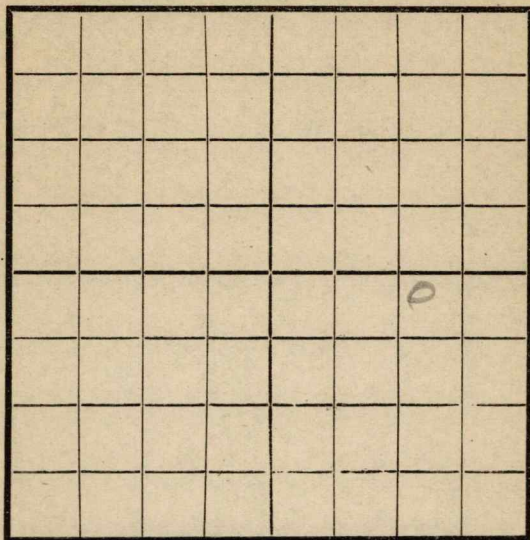

EAST

SOUTH

Location _____

Rig Up _____

Drilling and remarks

1160

RECORD

Cased _____ in. _____ Ft.

Sand _____

Gas _____

Oil _____

Total Depth _____

PRODUCTION

1st 24 hrs. Nat. _____

1st 24 hrs. after shot _____

Gas _____ Cu. Ft.

Dry Hole _____

Abandoned _____


Date

10/9, 1917 Carney Scout

Map No. _____ Sec. 13 Twp. 27 R. 6Well No. 1st Stephens Farm _____Central Oil Company _____

NORTH

WEST

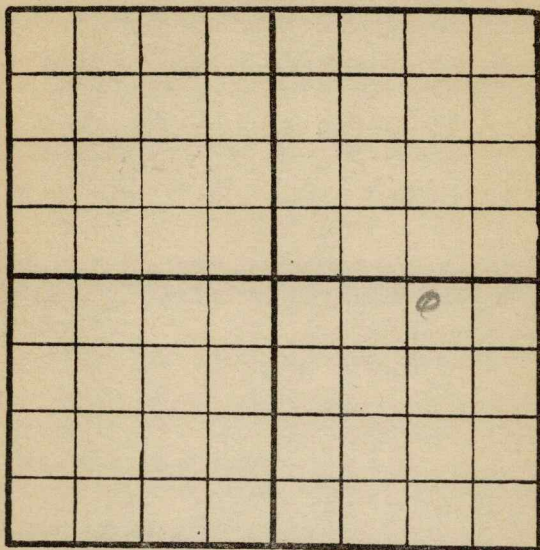

EAST

SOUTH

Location _____

Rig up _____

Drilling and remarks:

1635

RECORD

Cased _____ in. _____ Ft.

Sand _____

Gas _____

Oil _____

Total Depth _____

PRODUCTION

1st. 24 hrs. Nat. _____

1st. 24 hrs. after shot. _____

Gas _____ Cu. Ft.

Dry Hole _____

Abandoned _____


Date

10/17 1917 Conley Scout

Map No. _____ Sec. 13 Twp. 27 R. 6Well No. Stebbins Farm _____Century Company _____

NORTH

WEST

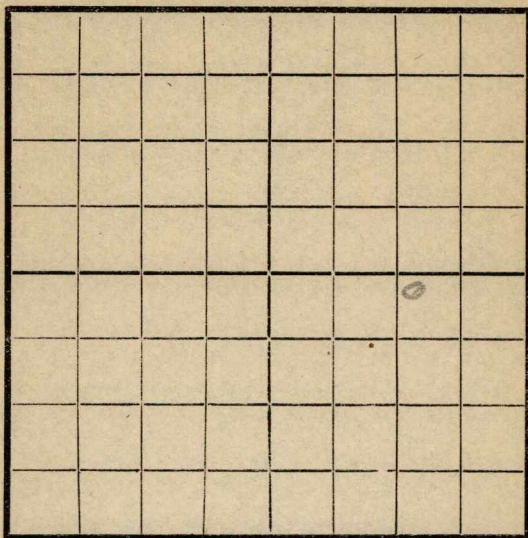

EAST

SOUTH

Location _____

Rig Up _____

Drilling and remarks

1850

RECORD

Cased _____ in. _____ Ft.

Sand _____

Gas _____

Oil _____

Total Depth _____

PRODUCTION

1st 24 hrs. Nat. _____

1st 24 hrs. after shot _____

Gas _____ Cu. Ft.

Dry Hole _____

Abandoned _____


Date

10/24, 1912 Century Scout

Map No. _____ Sec. 13 Twp. 27 R. 6Well No. 1 Stebbins Farm _____Central Company _____

NORTH

WEST

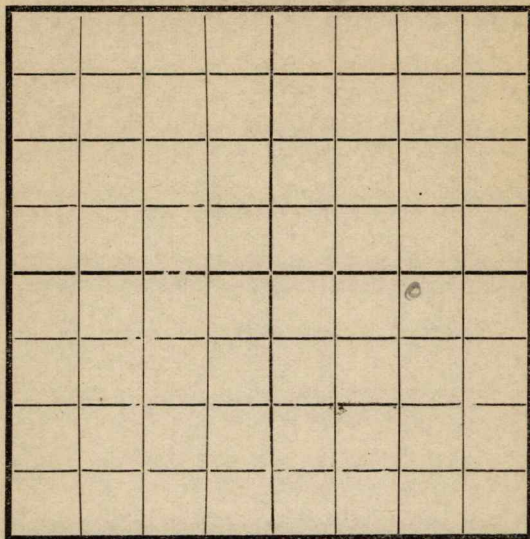

EAST

SOUTH

RECORD

Location _____

Cased _____ in. _____ Ft.

Rig Up _____

Sand _____

Drilling and remarks

Gas _____

Oil _____

Total Depth _____

2105

PRODUCTION

1st 24 hrs. Nat. _____

1st 24 hrs. after shot _____

Gas _____ Cu. Ft.

Dry Hole _____

Abandoned _____

Date

10/31

, 191


7Carly

Scout

Map No. _____ Sec. 13 Twp. 27 R. 6Well No. 1 Stebbins Farm
Central Oil Co Company

NORTH

WEST

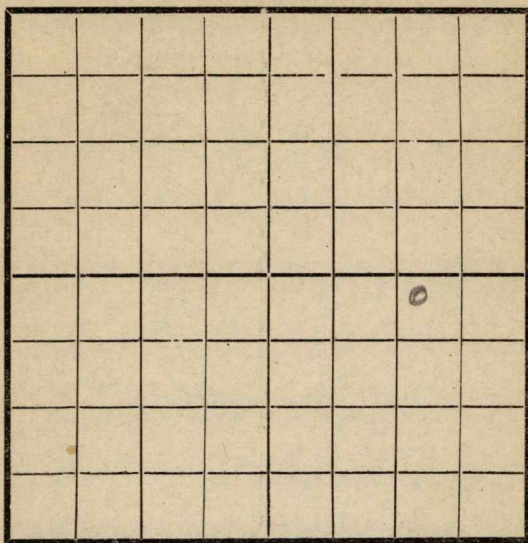

EAST

SOUTH

Location _____

Rig Up _____

Drilling and remarks

2350

RECORD

Cased _____ in. _____ Ft.

Sand _____

Gas _____

Oil _____

Total Depth _____

PRODUCTION

1st 24 hrs. Nat. _____

1st 24 hrs. after shot _____

Gas _____ Cu. Ft.

Dry Hole _____

Abandoned _____

Date


11-7191Condeff

Scout

Map No. _____ Sec. 13 Twp. 27 R. 6Well No. 1 Stebbins Farm
Central Oil Co. Company

NORTH

WEST

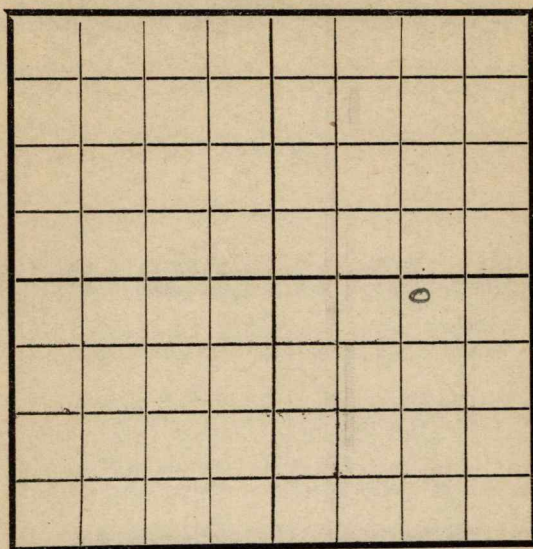

EAST

SOUTH

RECORD

Location _____

Cased _____ in. _____ Ft.

Rig Up _____

Sand _____

Drilling and remarks

Gas _____

Oil _____

Total Depth _____

2750

PRODUCTION

1st 24 hrs. Nat. _____

1st 24 hrs. after shot _____

Gas _____ Cu. Ft.

Dry Hole _____


Abandoned _____

Date

11-14, 1917 Carley Scout

Map No. _____ Sec. 13 Twp. 27 R. 6Well No. 1 Stebbins Farm _____Moll-Hyde Oil Company _____Central Oil NORTH Co

WEST

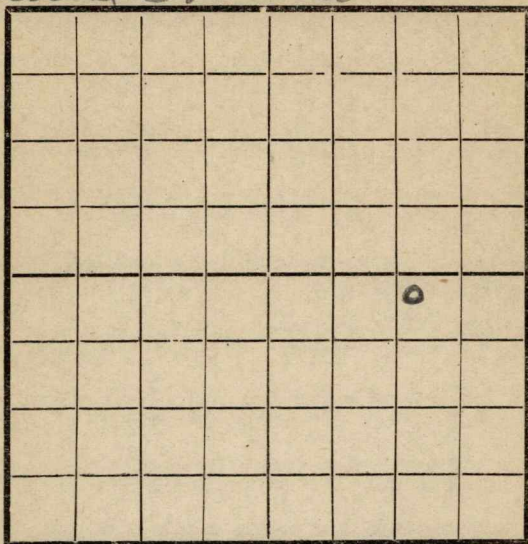

EAST

SOUTH

Location _____

Rig Up _____

Drilling and remarks

Shut Down
2730

RECORD

Cased _____ in. _____ Ft.

Sand _____

Gas _____

Oil _____

Total Depth _____

PRODUCTION

1st 24 hrs. Nat. _____

1st 24 hrs. after shot _____

Gas _____ Cu. Ft.

Dry Hole _____

Abandoned _____


Date

11/21, 191*7* *Carney* Scout

Map No. _____ Sec. 13 Twp. 27 R. 6Well No. 1 Stebbins Farm _____Mall-Hyde oil Company _____

NORTH

WEST

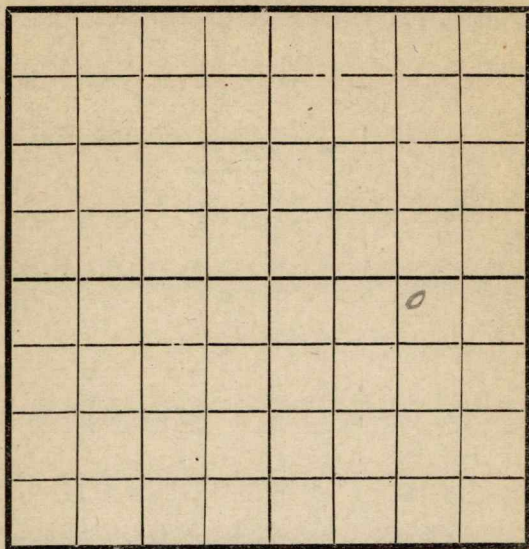

EAST

SOUTH

Location _____

Rig Up _____

Drilling and remarks

*Under-running
from 2665 to
2730*

RECORD

Cased _____ in. _____ Ft.

Sand _____

Gas _____

Oil _____

Total Depth _____

PRODUCTION

1st 24 hrs. Nat. _____

1st 24 hrs. after shot _____

Gas _____ Cu. Ft.

Dry Hole _____


Abandoned _____

Date

11/28, 1917 *Candey* Scout

Map No. K11 Sec. 13 Twp. 27 R. 6Well No. 1st stephens Farm
Smalls-Hyde Company

NORTH

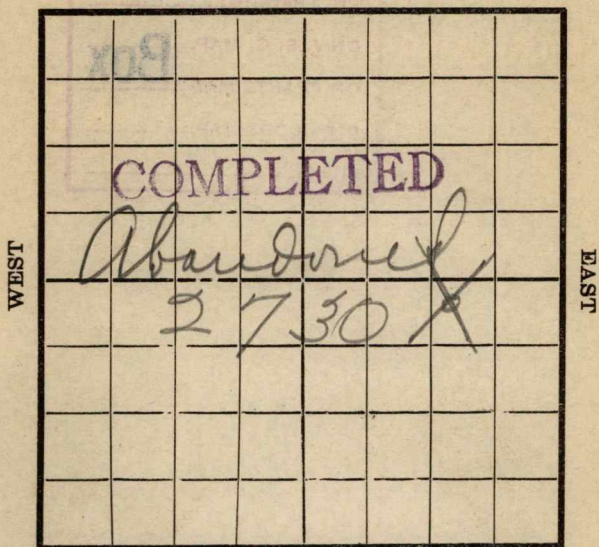

SOUTH

Location -----

Rig Up -----

Drilling and remarks

Coring hole

Will abandon

at 2730

RECORD

Cased ----- in. ----- Ft.

Sand -----

Gas -----

Oil -----

Total Depth -----

PRODUCTION

1st 24 hrs. Nat. -----

1st 24 hrs. after shot -----

Gas ----- Cu. Ft.

Dry Hole -----


Abandoned -----

Date

12/5, 1917 C. C. C. Scout

Map No. 511 Sec. 13 Twp. 27 R. 6Well No. 1 Stebbins Farm
Mollen-Hyde Oil & Gas Company

NORTH

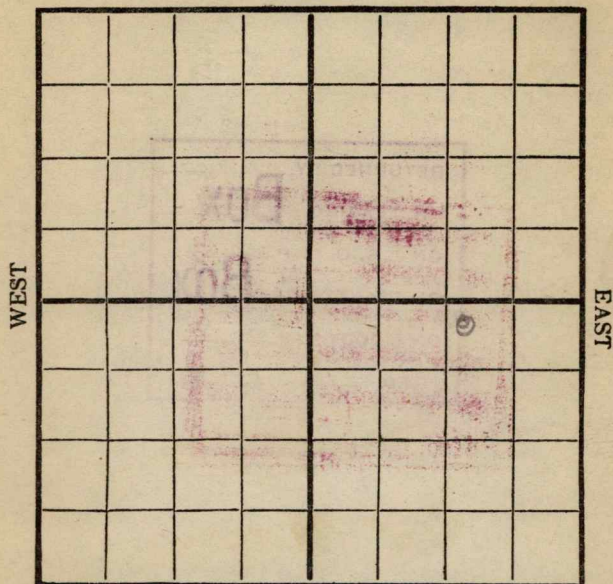

SOUTH

Location -----

Rig Up -----

Drilling and remarks

2860

Note: - I was told by
man in charge
that they were going
to abandon this at
2730 and sent in record
Dec 12 to that effect. but
they decided to go to 3000'

RECORD

Cased ----- in. ----- Ft.

Sand -----

Gas -----

Oil -----

Total Depth -----

PRODUCTION

1st 24 hrs. Nat. -----

1st 24 hrs. after shot -----

Gas ----- Cu. Ft.

Dry Hole -----

Abandoned -----


Date

1/2, 1918, Cordiff Scout

Map No. _____ Sec. 13 Twp. 27 R. 6Well No. 1 Stebbins Farm
Molle-Hyde Company

NORTH

WEST

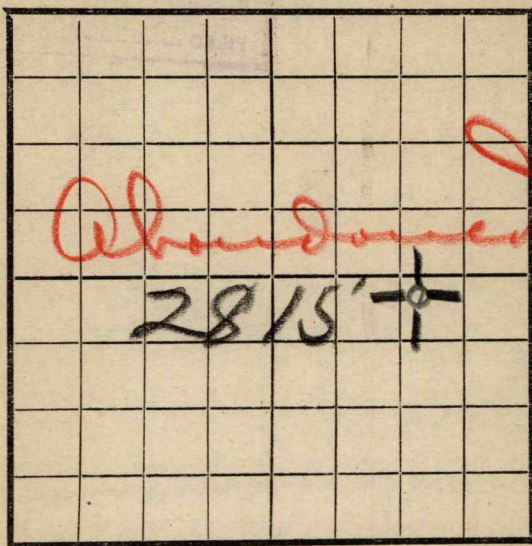

EAST

SOUTH

Location _____

Rig Up _____

Drilling and remarks

RECORD

Cased _____ in. _____ Ft.

Sand _____

Gas _____

Oil _____

Total Depth _____

PRODUCTION

1st 24 hrs. Nat. _____

1st 24 hrs. after shot _____

Gas _____ Cu. Ft.

Dry Hole _____

Abandoned _____

Date

1/23, 1918 O. Condeff Scout