


Rice

Section 6 Township 18 Range 10-W

Well No. 2 Stout

Company Gulf

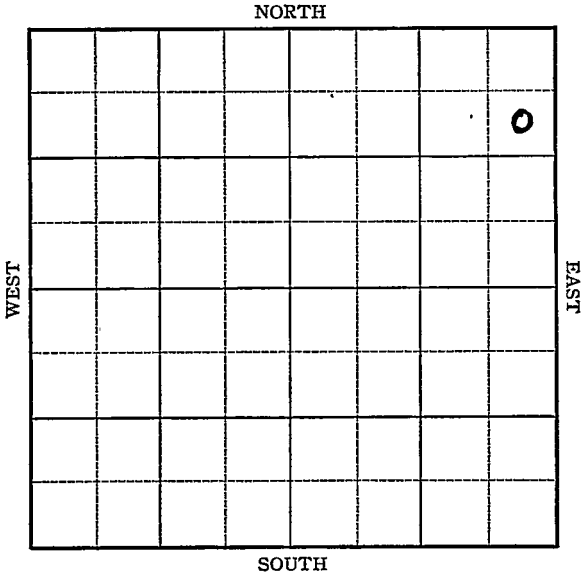


Sec. 6 Twp. 18 R. 10-WWell No. #2 Stout Farm \_\_\_\_\_Gulf Company990 Ft. from N. Line

\_\_\_\_\_ Ft. from S. Line

330 Ft. from E. Line

\_\_\_\_\_ Ft. from W. Line

Elev. 1790

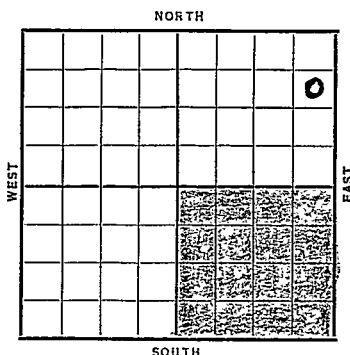

Date	REPORT
1937	
11/23	Cellar.
12/3	10" @ 205'. Drlg. 475'.
12/10	Drlg. 2850'.
12/17	K.C. 2941'. S.O. 2963'.
	T.D. 3012'. 7" @ 3012'. RUST.
12/24	T.D. 3022'. Flowed 250 bbls. oil.
	17 hrs. 6000 acid. Testing.
12/29	7" @ 3012'.
	K.C. 2941'.
	T.D. 3022'.
	6000 acid.
	Flowed 661 bbls. 4 hrs &
	546.8 bbls. 4 hrs.
	Potential 3282 bbls.
	326,000 gas.
	Gravity 40.6/46.
	<b>COMPLETED</b>

Map No. 53 Sec. 6 Twp. 18 R. 10W

Well No. 2 Stout

Gulf

Company

Contractor

**FIRST REPORT**  
**SE NE NE**

**SECTION PLAT**

990 Ft. from N. Line

			0

\_\_\_\_\_ Ft. from S. Line

330 Ft. from E. Line

\_\_\_\_\_ Ft. from W. Line

Location \_\_\_\_\_

Rig up \_\_\_\_\_

Drilling and Remarks:

**Cellar**

**RECORD**

Cased \_\_\_\_\_ in., \_\_\_\_\_ ft.

Sand \_\_\_\_\_

Gas \_\_\_\_\_

Oil \_\_\_\_\_

Total Depth \_\_\_\_\_

**PRODUCTION**

1st 24 hrs. Nat. \_\_\_\_\_

1st 24 hrs. after shot \_\_\_\_\_

Gas \_\_\_\_\_ Cu. Ft.

Dry Hole \_\_\_\_\_

Abandoned \_\_\_\_\_

Date

**NOV 23 1937**

19

**H. D. Hatfield**

Scout

Rice

KANSAS

Map No. 58 Sec. 6 Twp. 18 R. 10WWell No. 2 StoutGulf

Company

Contractor

## SECTION PLAT

SE NE NE

990 Ft. from N. Line

Ft. from S. Line

330 Ft. from E. Line

Ft. from W. Line

COMPLETED

			0

Location \_\_\_\_\_

Rig up \_\_\_\_\_

Drilling and Remarks:

6000 acid  
flowed 66 1/4 x 546 1/4  
POT - 3282  
326,000 gas  
grav 40.6/46

## RECORD

Cased 7 in., 3012 ft.Sand KC, 2941

Gas \_\_\_\_\_

Oil \_\_\_\_\_

Total Depth 3022

## PRODUCTION

1st 24 hrs. Nat. \_\_\_\_\_

1st 24 hrs. after shot \_\_\_\_\_

Gas \_\_\_\_\_ Cu. Ft.

Dry Hole \_\_\_\_\_

Abandoned \_\_\_\_\_

Date

DEC 29 1937H. D. Hatfield

Scout