


(709)
Map No. _____ Sec. 23 Twp. 23 R. 13
Well No. 7 Bahr Farm _____
Atlantic Company _____

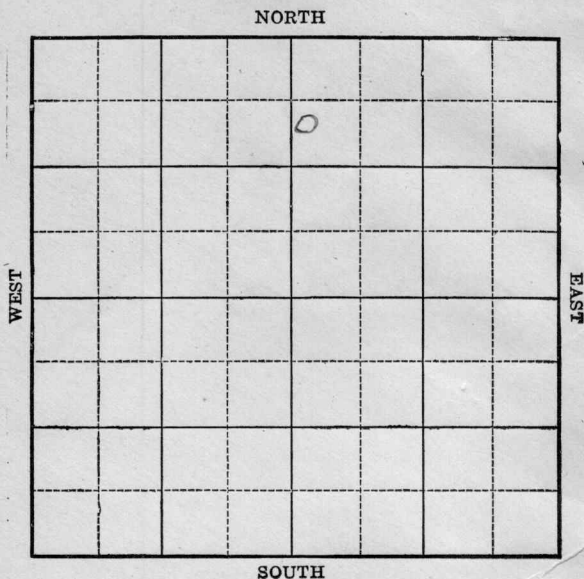

Location _____

Drilling Remarks:

Rig up _____

Drilling Remarks:

RECORD

Cased _____ in. _____ ft.

Sand _____

Gas _____

Oil _____

Total Depth _____

PRODUCTION

1st 24 hrs Nat. _____

1st 24 hrs. after shot _____

Gas _____ cu. ft.

Dry Hole _____

Abandoned _____

Map No. _____ Sec. 23 Twp. 23 R. 13


Well No. 7 Bahn Farm
Atlanti Company

760 Ft. from N, Line

Ft. from S. Line

Ft. from E. Line

200 Ft. from W. Line

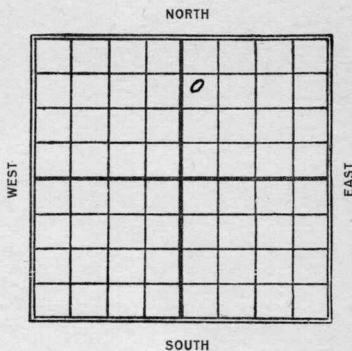

Date
1923

REPORT

1/6	Spred.
2/1	I.D. 1805- 80 Bbl.

KANSAS 17 23 23 13
 Map No. _____ Sec. _____ Twp. _____ R. _____

Well No. 7-Bahr _____

Atlantic _____ Company

_____ Contractor

FIRST REPORT

760 _____ Ft. from N. Line

_____ Ft. from S. Line

_____ Ft. from E. Line

200 _____ Ft. from W. Line

SECTION PLAT

Location _____

Rig up _____

Drilling and Remarks:

is paid.

RECORD

Cased _____ in., _____ ft.

Sand _____

Gas _____

Oil _____

Total Depth _____

PRODUCTION

1st 24 hrs. Nat. _____

1st 24 hrs. after shot _____

Gas _____ Cu. Ft.

Dry Hole _____

Abandoned _____

Date

M. A. BENEAR

JAN 6 1923 191

_____ Scout

Map No. **KANSAS** 17 Sec. 23 Twp. 23 R. 13Well No. 7 BahrCompany Atlantic

Contractor _____

COMPLETED SECTION PLAT760 Ft. from N. Line

_____ Ft. from S. Line

_____ Ft. from E. Line

200 Ft. from W. Line

		0	

RECORD

Location _____

Rig up _____

Drilling and Remarks:

Tap L. 1762'
shot 40 gals.

Cased _____ in., _____ ft.

Sand _____

Gas _____

Oil 1789-99Total Depth 1805**PRODUCTION**

1st 24 hrs. Nat. _____

1st 24 hrs. after shot 10

Gas _____ Cu. Ft.

Dry Hole _____

Abandoned _____

Date

FEB 6 1923

191

M. A. BENEAR

Scout