

KANSAS

Rice


Form 51-5M-7-39-Palace

Section 6 Township 18 Range 10-W

Well No. #5 Ames


Company Gulf

Bloomer Pool

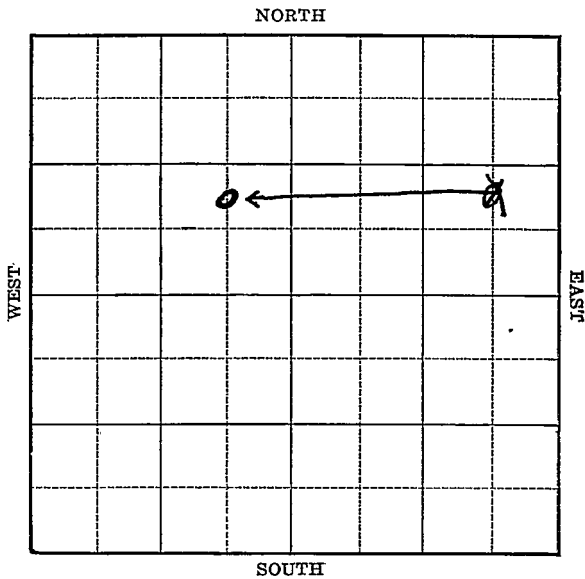

(Bloomer)

Ft. from W. Line

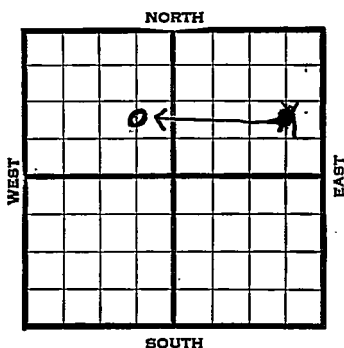[illegible]

Map No. 55 Sec. 6 Twp. 18 R. 10WWell No. 5 Ames

Gulf

Company

Contractor

FIRST REPORT

C N L SE NW

 Ft. from N. Line990 Ft. from S. Line660 Ft. from E. Line Ft. from W. Line

SECTION PLAT

			o

BLOOMER POOL

Location Rig up

Drilling and Remarks:

Rotary

RECORD

Cased in., ft.Sand Gas Oil Total Depth

PRODUCTION

1st 24 hrs. Nat. 1st 24 hrs. after shot Gas Cu. Ft.Dry Hole Abandoned

Date

MAY 8 1940₁₉

S. J. LEWIS

Scout

Map No. 55 Sec. 6 Twp. 18 R. 10WWell No. 5 AmesGulf

Company

Contractor

COMPLETED**C N L SE NW** Ft. from N. Line990 Ft. from S. Line660 Ft. from E. Line Ft. from W. Line**SECTION PLAT**

	←	→	
Correct spot.			

BLOOMER POOLLocation Rig up

Drilling and Remarks:

*Ar 73229**5" @ 3229**2000 acid*** Sonicmeter R & T**30268**Net 3000***RECORD**Cased in., ft.Sand Gas Oil Total Depth 3230**PRODUCTION**1st 24 hrs. Nat. 1st 24 hrs. after shot Gas Cu. Ft.Dry Hole Abandoned

Date

JUN 5 1940 19S. J. LEWIS Scout