

KANSAS


Form 51-5M-7-39-Palace

Rice

Section 6 Township 18 Range 10-W

Well No. #5 Stout

Company Gulf

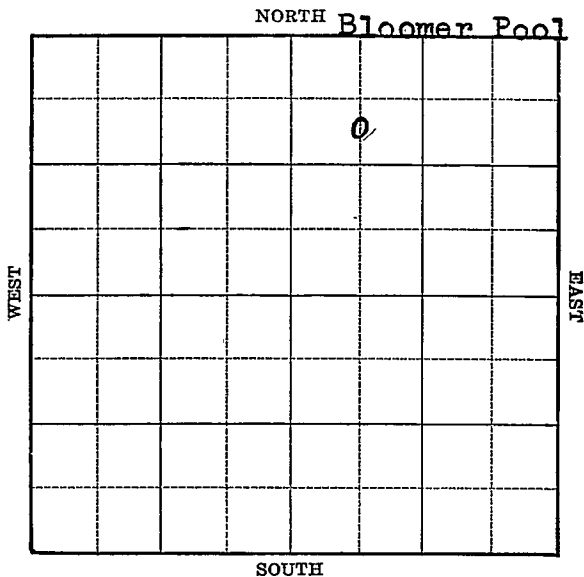

Sec. 6 Twp. 18 R. 10-W

Well No. #5 Stout Farm _____

Gulf Company _____

(Bloomer)

990 Ft. from N. Line

_____ Ft. from S. Line

_____ Ft. from E. Line

660 Ft. from W. Line

Elev. 1795



1940 REPORT

1/31 Rotary.

2/8 8" - 211' Drlg. 2003'

2/15 Drlg. 3217'

2/23 Arb. 3225' 5 1/2" - 3225'
 T.D. 3230' Swab 292 bbls. 5 hrs
 Shut down.

2/28 Arb. 3225'

5 1/2" - 3225'

T.D. 3230'

Soniometer 14,692 bbls.

Maximum 3000 bbls.

COMPLETED

Map No. 55 Sec. 6 Twp. 18 R. 10WWell No. 5 StoutGulf

Company

Contractor

FIRST REPORTC $S\frac{1}{2}$ NW NE990 Ft. from N. Line Ft. from S. Line Ft. from E. Line660 Ft. from W. Line**SECTION PLAT**

		o	

BLOOMER POOL

Location _____

Rig up _____

Drilling and Remarks:
Rotary**RECORD**

Cased _____ in., _____ ft.

Sand _____

Gas _____

Oil _____

Total Depth _____

PRODUCTION

1st 24 hrs. Nat. _____

1st 24 hrs. after shot _____

Gas _____ Cu. Ft.

Dry Hole _____

Abandoned _____

Date

JAN 31 1940

19

S. J. LEWIS

Scout

Map No. 55 Sec. 6 Twp. 18 R. 10WWell No. 5 Stout

Gulf

Company

Contractor

COMPLETED

SECTION PLAT

990 C $S\frac{1}{2}$ NW NE
 Ft. from N. Line
 _____ Ft. from S. Line
 _____ Ft. from E. Line
660 Ft. from W. Line

		o	

BLOOMER POOL

Location _____

Rig up _____

Drilling and Remarks:

*Cor 8 3225**5 1/2 @ 3225**Committed 14692**P.S.**Maximum 3000*

RECORD

Cased _____ in., _____ ft.

Sand _____

Gas _____

Oil _____

Total Depth 3230

PRODUCTION

1st 24 hrs. Nat. _____

1st 24 hrs. after shot _____

Gas _____ Cu. Ft.

Dry Hole _____

Abandoned _____

Date

FEB 28 1940 19

S. J. LEWIS

Scout