KANSAS
Form 51—5M—7-40—Palace


Rice

Section 6 Township 18 Range 10-W

Well No. 6 Ames

Company Gulf

Bloomer Pool

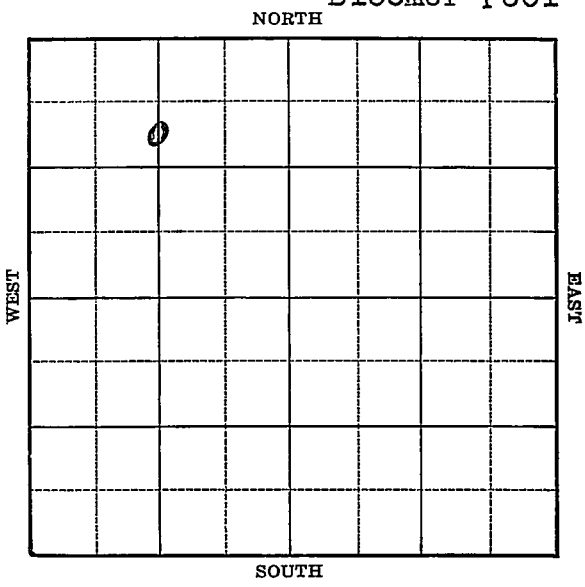

FORM 252-A 5M 2-40

KANSAS

Rice

Sec. 6 Twp. 18 R. 10-W

Well No. #6 Ames Farm

Gulf Company

(Bloomer)


990 Ft. from N. Line

Ft. from S. Line

1326 Ft. from E. Line

Ft. from W. Line

Elev. 1801

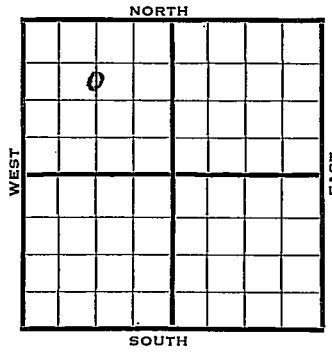

1941	REPORT
1/22	Rotary.
1/30	8" - 206' Drlg. 2171'
2/6	Arb. 3234-36' T.D. 6" - 3235'
	S.O. RUST.
2/13	T.D. 3241' Swab 270 oil in 8
	hours.
2/20	1000 acid. Testing.
2/27	" " " "
3/6	" " " "
3/12	Arb. 3234'
	6" - 3235'
	T.D. 3241'
	1000 acid.
	Soniemeter potential 7506 bbls.
	Maximum 3000 bbls.
	42.6 Gravity
	COMPLETED

Form 26—200 Bks.—1-40—Palace Rice KANSAS

Map No. 55 Sec. 6 Twp. 18 R. 10W

Well No. 6 Ames

Gulf Company

FIRST REPORT Contractor

C S L N½ NW

990 Ft. from N. Line


____ Ft. from S. Line

1326 Ft. from E. Line

____ Ft. from W. Line

BLOOMER POOL

SECTION PLAT

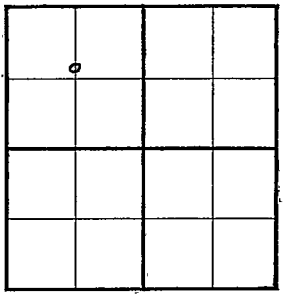

Location ____

Rig up ____

Drilling and Remarks:
Rotary

RECORD

Cased ____ in., ____ ft.

Sand ____

Gas ____

Oil ____

Total Depth ____

PRODUCTION

1st 24 hrs. Nat. ____

1st 24 hrs. after shot ____

Gas ____ Cu. Ft.

Dry Hole ____

Abandoned ____

Date

JAN 22 1941 19

S. I. LEWIS Scout

Form 26—200 Bks.—1-40—Palace Rice KANSAS

Map No. 55 Sec. 6 Twp. 18 R. 10W

Well No. 6 Ames

Gulf Company

COMPLETED Contractor

C S L N½ NW

990 Ft. from N. Line


_____ Ft. from S. Line

1326 Ft. from E. Line

_____ Ft. from W. Line

BLOOMER POOL

SECTION PLAT

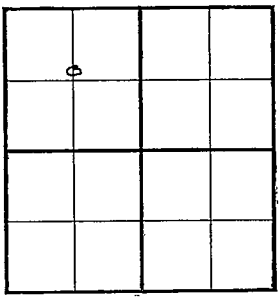

Location _____

Rig up _____

Drilling and Remarks:

Cr ¥ 8234

6" @ 8235

1000 Acid

Sonicmeter 7506

7506

Plug 3000

426 Ft.

RECORD

Cased _____ in., _____ ft.

Sand _____

Gas _____

Oil _____

Total Depth 8241

PRODUCTION

1st 24 hrs. Nat. _____

1st 24 hrs. after shot _____

Gas _____ Cu. Ft.

Dry Hole _____

Abandoned _____

Date

MAR 12 1941 19

S. J. LEWIS Scout