

# KANSAS

Rice


FORM 51 5M 4-41 PETROL

Section 7 Township 18 Range 10-W

Well No. 1 Radenberg

Company Champlin Refining

NORTH Bloomer pool

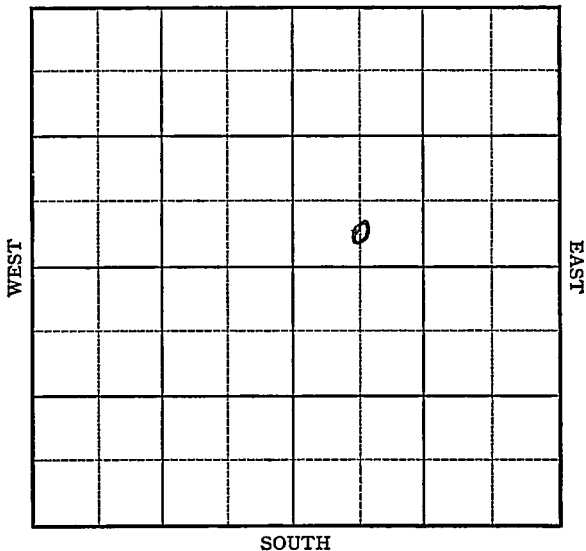




Map No. K-55 Sec. 7- Twp. 18 R. 10WWell No. 1 RadenbergChamplin Refining Company**FIRST REPORT** Contractor

C SL SW NE

         Ft. from N. Line330 Ft. from S. Line         Ft. from E. Line660 Ft. from W. Line

## SECTION PLAT

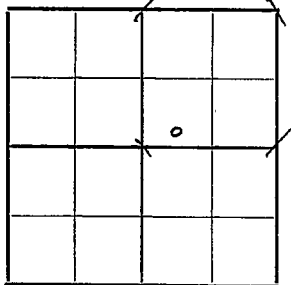

BLOOMER POOL

Location                                 Rig up                                 

Drilling and Remarks:

Drlg. 100'

## RECORD

Cased          in.,          ft.Sand                                 Gas                                 Oil                                 Total Depth                         

## PRODUCTION

1st 24 hrs. Nat.                         1st 24 hrs. after shot                         Gas                          Cu. Ft.Dry Hole                         Abandoned                         

Date

OCT 1 1941S. J. LEWIS Scout

Rice

**KANSAS**

Map No. 155 Sec. 7 Twp. 18 R. 10W

Well No. 1 Radenberg

Champlin Refining Company

ABANDONED Contractor

**SECTION PLAT**

C SL SW NE

\_\_\_\_\_ Ft. from N. Line

330 Ft. from S. Line

\_\_\_\_\_ Ft. from E. Line

660 Ft. from W. Line

		o	

**BLOOMER POOL**

Location \_\_\_\_\_

Rig up \_\_\_\_\_

Drilling and Remarks:

*Cor 83318*  
*Noshows.*  
*Lans. 2995*

**RECORD**

Cased \_\_\_\_\_ in., \_\_\_\_\_ ft.

Sand \_\_\_\_\_

Gas \_\_\_\_\_

Oil \_\_\_\_\_

Total Depth 3400

**PRODUCTION**

1st 24 hrs. Nat. \_\_\_\_\_

1st 24 hrs. after shot \_\_\_\_\_

Gas \_\_\_\_\_ Cu. Ft.

Dry Hole \_\_\_\_\_

Abandoned \_\_\_\_\_

Date

OCT 22 1941 19

S. J. LEWIS Scout