

KANS.


FORM 51 5M 10-41 PETROL

Rice

Section 6 Township 18 Range 10-W

Well No. #6 Roesler

Company Transwestern etal.

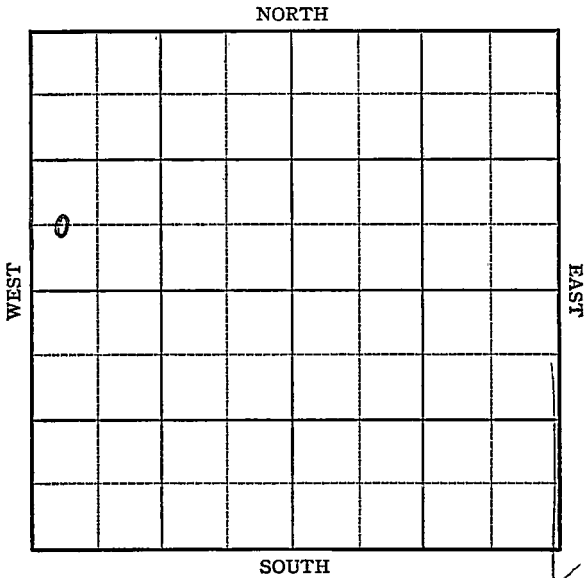



Map No. H-55 Sec. 6 Twp. 18 R. 10WWell No. 6 RoeslerTranswestern et al. Company**FIRST REPORT**

Contractor

C WL SW NW

**SECTION PLAT**

|   |  |  |  |
|---|--|--|--|
|   |  |  |  |
| 0 |  |  |  |
|   |  |  |  |
|   |  |  |  |

         Ft. from N. Line660 Ft. from S. Line         Ft. from E. Line330 Ft. from W. Line**BLOOMER POOL**Location                         Rig up                         

Drilling and Remarks:

10" - 210'

Waiting on  
cement to set**RECORD**Cased          in.,          ft.Sand                         Gas                         Oil                         Total Depth                         **PRODUCTION**1st 24 hrs. Nat.                         1st 24 hrs. after shot                         Gas                          Cu. Ft.Dry Hole                         Abandoned                         

Date

NOV 12 1941

19

S. J. LEWIS

Scout

Map No. 55 Sec. 6 Twp. 18 R. 10WWell No. 6 RoeslerTranswestern et al. CompanyCOMPLETED Contractor

C WL SW NW

\_\_\_\_\_ Ft. from N. Line

660 Ft. from S. Line

\_\_\_\_\_ Ft. from E. Line

330 Ft. from W. Line

## SECTION PLAT

|  |  |  |  |
|--|--|--|--|
|  |  |  |  |
|  |  |  |  |
|  |  |  |  |
|  |  |  |  |

## BLOOMER POOL

Location \_\_\_\_\_

Rig up \_\_\_\_\_

Drilling and Remarks:

*Car 8237**5" C 8237**2000 Acial**Echd R 8237**426 Gr*

## RECORD

Cased \_\_\_\_\_ in., \_\_\_\_\_ ft.

Sand \_\_\_\_\_

Gas \_\_\_\_\_

Oil \_\_\_\_\_

Total Depth 3237

## PRODUCTION

1st 24 hrs. Nat. \_\_\_\_\_

1st 24 hrs. after shot \_\_\_\_\_

Gas \_\_\_\_\_ Cu. Ft.

Dry Hole \_\_\_\_\_

Abandoned \_\_\_\_\_

Date

DEC 3 1941S. J. LEWIS Scout