

Section 6 Township 18 Range 10-W

Well No. #6 B. F. Stout


Company Gulf

Bloomer Pool

NORTH

WEST

EAST

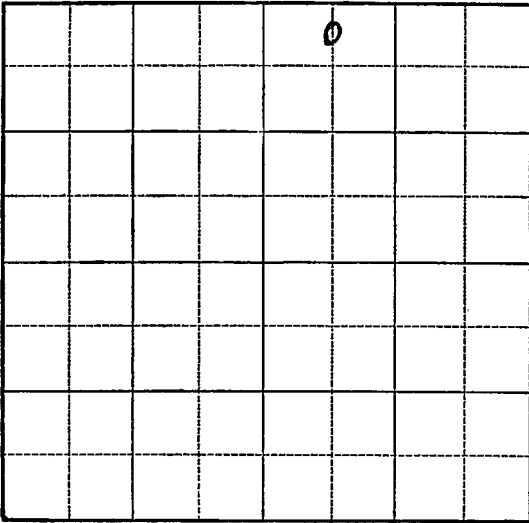

SOUTH

Sec. 6 Twp. 18 R. 10-WWell No. #6 B. F. Stout FarmGulf Company

(Bloomer)


330 Ft. from N. Line

\_\_\_\_\_ Ft. from S. Line

\_\_\_\_\_ Ft. from E. Line

660 Ft. from W. Line

Elev. 1797

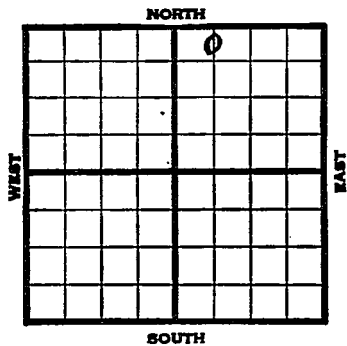

1940	REPORT
2/21	Derrick.
2/29	8" - 259' Drlg. 1370'
3/8	Drlg. 2712'
3/14	Arb. 3223' 5 $\frac{1}{2}$ " - 3223'
	T.D. 3224' RUST.
3/21	T.D. 3229' Swab 15 bbls. per hour for 3 hours.
3/28	" " "
4/3	Arb. 3223'
	5" - 3223'
	T.D. 3229'
	Depthograph potential 5611 bbls.
	Maximum 3000 bbls.
	<b>COMPLETED</b>

Map No. 55 Sec. 6 Twp. 18 R. 10WWell No. 6 B.F. Stout

Gulf

Company

Contractor

## FIRST REPORT

C N L NW NE

## SECTION PLAT

		o	

330 Ft. from N. Line

\_\_\_\_\_ Ft. from S. Line

\_\_\_\_\_ Ft. from E. Line

660 Ft. from W. Line

## BLOOMER POOL

Location \_\_\_\_\_

Rig up \_\_\_\_\_

Drilling and Remarks:

**Derrick**

## RECORD

Cased \_\_\_\_\_ in., \_\_\_\_\_ ft.

Sand \_\_\_\_\_

Gas \_\_\_\_\_

Oil \_\_\_\_\_

Total Depth \_\_\_\_\_

## PRODUCTION

1st 24 hrs. Nat. \_\_\_\_\_

1st 24 hrs. after shot \_\_\_\_\_

Gas \_\_\_\_\_ Cu. Ft.

Dry Hole \_\_\_\_\_

Abandoned \_\_\_\_\_

Date

FEB 21 1940 19S. LEWIS Scout

Map No. 55 Sec. 6 Twp. 18 R. 10W

Well No. 6 B. F. Stout

Gulf Company

Contractor

**COMPLETED**

C N L NW NE

330 Ft. from N. Line

\_\_\_\_\_ Ft. from S. Line

\_\_\_\_\_ Ft. from E. Line

660 Ft. from W. Line

**BLOOMER POOL**

**SECTION PLAT**

		o	

Location \_\_\_\_\_

Rig up \_\_\_\_\_

Drilling and Remarks:

*Art 3223*

*5" @ 3223*

*Depthograph Sat  
5615*

*Maximum 3000*

**RECORD**

Cased \_\_\_\_\_ in., \_\_\_\_\_ ft.

Sand \_\_\_\_\_

Gas \_\_\_\_\_

Oil \_\_\_\_\_

Total Depth 3229

**PRODUCTION**

1st 24 hrs. Nat. \_\_\_\_\_

1st 24 hrs. after shot \_\_\_\_\_

Gas \_\_\_\_\_ Cu. Ft.

Dry Hole \_\_\_\_\_

Abandoned \_\_\_\_\_

Date

APR 3 1940 19

S. J. LEWIS Scout