


Section 15 Township 27 Range 6 E

Well No. #1 Marshall

Company A. D. Allison & Co., Inc.

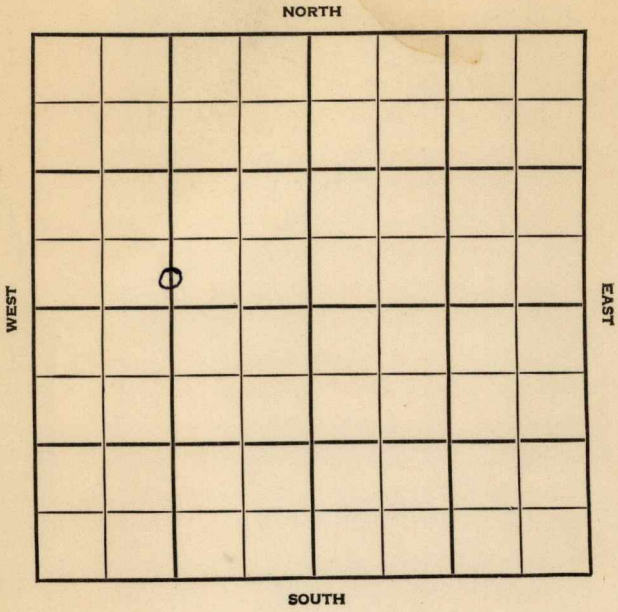

Butler

KANSAS


SEC. 15	TWP. 27	R. 6E
------------	------------	----------

WELL NO. #1 Marshall FARM

COMPANY A. D. Allison & Co., Inc.

CONTRACTOR Wixson

_____ Ft. from N. Line
 300' _____ Ft. from S. Line
 _____ Ft. from E. Line
 _____ Ft. from W. Line

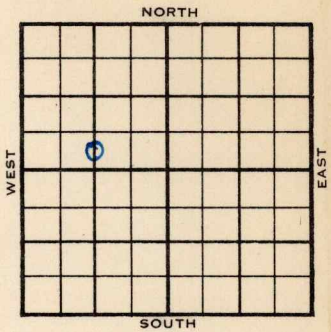

C S $\frac{1}{2}$ S $\frac{1}{2}$ NW

1955	ELEVATION 1350'	REPORT
------	--------------------	--------

8/24 RUCT

9/28 Comm 8-25-55
 15 1/2" @ 2814 13" @ 904
 10" @ 1653 8" @ 2267 HFW
 L 1730
 KC 2080
 M 2709
 B 3020
 V 3084
 TD 3094
 D&A

ABANDONED

County Butler Elev. 1350
 Sec. 15 Twp. 27 Rge. 6E
 Company A. D. Allison & Co., Inc.
 Farm Name Marshall No. 1

TOPS	DEPTH	LOG	DATUM
Anh.			
Tp.			
H.			
Tr.			
Dg.			
Bl.			
L.	<u>1730</u>		<u>380</u>
K.C.	<u>2080</u>		<u>730</u>
B.K.C.			
Ce.			
C.			
M.	<u>2709</u>		<u>1359</u>
M. <u>B.</u>	<u>3626</u>		<u>1676</u>
K.			
Mz.			
Me.			
V.	<u>3084</u>		<u>1734</u>
S.			
S.			
A.			
R.			
Pe.			
G.			
T.D.	<u>3094</u>		

Loc. in Sec. C S $\frac{1}{2}$ S $\frac{1}{2}$ NW
300' SL

Geol. _____
 Contr. _____
Wixson
 Pool _____




Date Comm. 8-25-55 SEP 28 1955

15 $\frac{1}{2}$ " @ 284 13" @ 904 10" @ 1653

8" @ 2267 HFV

D & A

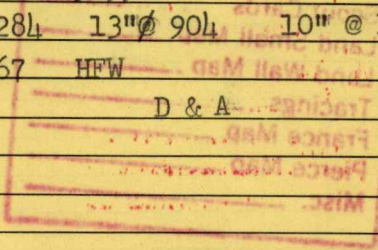

County **Butler** Elev. _____
 Sec. **15** Twp. **27** Rge. **6E**
 Company **A. D. Allison & Co., Inc.**
 Farm Name **Marshall** No. **1**

TOPS	DEPTH	LOG	DATUM
Anh.			
Tp.			
H.			
Tr.			
Dg.			
Bl.			
L.			
K.C.			
B.K.C.			
Ce.			
C.			
M.			
M.			
K.			
Mz.			
Me.			
V.			
S.			
S.			
A.			
R.			
PE.			
G.			
T.D.			

Loc. in Sec. _____
C S $\frac{1}{2}$ S $\frac{1}{2}$ NW
300' SL
 Geol. _____
 Contr. _____
Wixson
 Pool _____

AUG 24 1955
FIRST REPORT

Misc. Price Map
France Map
Price Map

Date Comm. _____
RUCF

Co. _____
 Lse. _____
 No. _____
 Sec. _____
 T. _____
 R. _____