


M.L.

Location 735' from N. Line
260' " W "

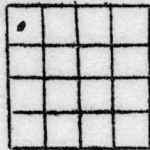

Sec. 21, T. 23, R. 13^E_W

Farm V. M. Griblin No. 3 County Greenwood

Company Atlantic Petr.

Commenced _____ Completed _____

Elevation _____ T.D. 1733 I. P. _____

585-1030 K.C. Line


1345 Oswego base

1706 Shale to Top Miss.?

1733 Sand T.D. No Log Available

PLOTTED LOG ONLY

Kansas
 Greenwood County
 21-23-13
 Atlantic Pet. Corp.
 Viola M. Gribbin #3
 N.W. 1/4
 735' from N. line & 260' from W. line.

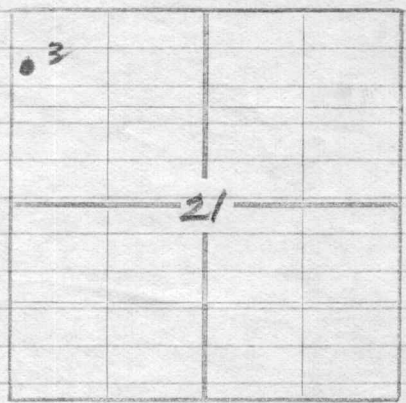

- Seat - 10
- L 4 sl - 160
- sl - 185
- L - 190
- sl - 210
- L - 230
- sl - 235
- L - 270
- sl - 375
- S - 395 (H.F.W.)
- L - 420
- sl - 585
- L - 605
- sl - 640
- L - 875 (2.1 B.W.)
- R.P. - 882
- sl - 890
- L - 970
- sl - 1002
- L - 1030
- sl - 1175
- L - 1195
- sl - 1210
- L - 1250
- sl - 1270
- L - 1285
- sl - 1290
- L - 1310
- S - 1325 (H.F.W.)
- L - 1345
- sl - 1706
- S - 1733 T.D.

Corr - 1-6-22
 Fin - 2-2-22
 Casing Record -
 12 1/2" - 431'
 10" - 996'
 8 1/4" - 1351'
 6 5/8" - 1723'

Soil	10	10
Lime and slate	150	160
Blue slate	25	185
White Lime	5	190
Blue slate	20	210
White lime	20	230
Black slate	5	235
White lime	35	270
Black slate	5	275
Blue slate	100	375
Sand	20	395 H.F.W.
White lime	25	420 Set 12 1/2" at 427'
Blue slate	165	585
White lime	20	605
Green slate	35	640
White lime	235	875 2 Bailers water
White red rock	7	882
White slate	8	890
Lime	80	970
Black slate	33	1003 Set 10" at 1001
White lime	27	1030
Blue shale	135	1165
White shale	10	1175
Lime	20	1195
Blue shale	15	1210
White lime	40	1250
Blue shale	20	1270
White lime	15	1285
Black shale	5	1290
Lime white	20	1310
White sand	15	1325 Hole F. W.
White sand	20	1345 Set 8 1/2" at 1337'
White shale	361	1706 Set 6 5/8 at 1706-
Sand	27	1733 Total depth

Casing:

12 1/2"	50	431'
10"	40	996'
8 1/2"	24	1351'
6 5/8"	17	1723'