


Section 15 Township 27 Range 6E

Well No. #1 Marshall

Company H & M Drlg.

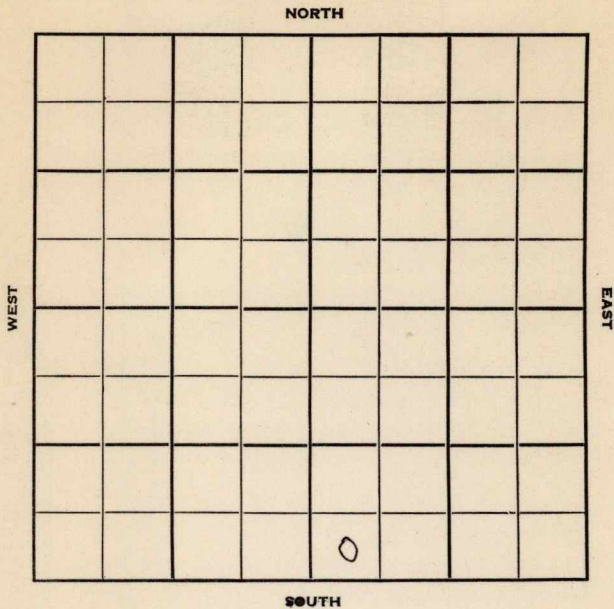

Butler

KANSAS



Sec. 15 Twp. 27 R. 6E

Well No. #1 Marshall Farm

H & M Drlg. Company

H & M Drlg. - Contr. Contractor

Wildcat


         Ft. from N. Line

330' Ft. from S. Line

         Ft. from E. Line

330' Ft. from W. Line

SW SW SE

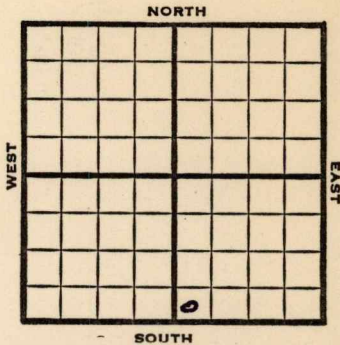

1952 **Elev. 1326'** REPORT

7/23 Spud 7-21-52  
8" @ 45  
WOC

7/30 Spud 7-21-52  
D&A TD 3079'  
8" @ 45  
**Miss. 2692** **B. Miss 3019**  
TD 3079 D&A

**ABANDONED**



