

Map No. K Sec. 21 Twp. 23 R. 13


Well No. 3 Sheplein Farm
Atlantic Pet Company

660 Ft. from N. Line

_____ Ft. from S. Line

_____ Ft. from E. Line

200 Ft. from W. Line

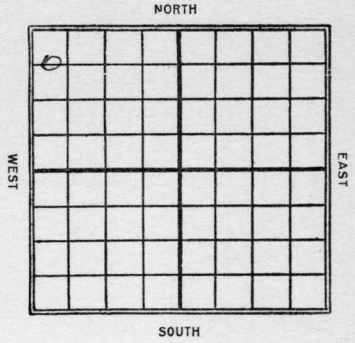

Date 1927


REPORT COMPLETED

1/15 - Spudding
2/4 - Sand 1707-29 F.L.
 shot 80 yds - pumping
 50 bbls.

Map No. K17 Sec. 21 Twp. 25 R. 13

Well No. 3, Dublin
of Hank's Pet Company.

660 from N. NORTH 200 from W.

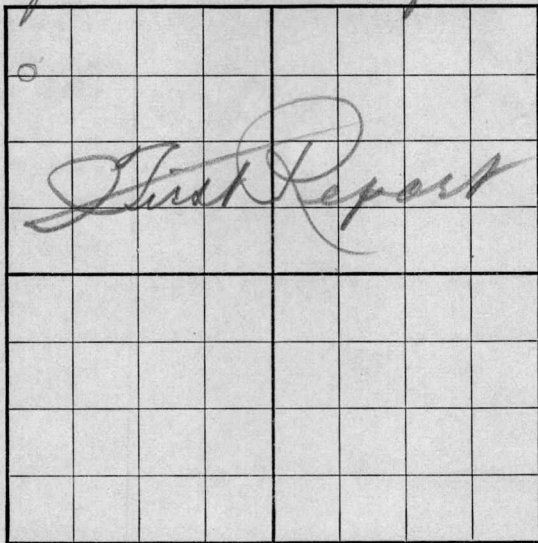

Location.....

Rig up.....

Drilling and Remarks:
spudding

RECORD

Cased..... in.,..... ft.
Sand.....
Gas.....
Oil.....
Total Depth.....

PRODUCTION

1st 24 hrs. Nat.....
1st 24 hrs. after shot.....
Gas..... Cu. Ft.
Dry Hole.....
Abandoned.....

State Kansas

Date 1/15 1922 W.B.
Scout

K17 *Kans* Map No. *21* Sec. *23* Twp. *13* R. *13*

Well No. *3* *Griffin* Company *Atlantic*

Contractor

COMPLETED

SECTION PLAT

660' Ft. from N. Line

_____ Ft. from S. Line

_____ Ft. from E. Line

200' Ft. from W. Line

0			

Location _____

Rig up _____

Drilling and Remarks:

sand-1707-29-70
shot 80 gals.
pumping
50 lbs

RECORD

Cased _____ in., _____ ft.

Sand _____

Gas _____

Oil _____

Total Depth _____

PRODUCTION

1st 24 hrs. Nat. _____

1st 24 hrs. after shot _____

Gas _____ Cu. Ft.

Dry Hole _____

Abandoned _____

Date

FEB 4 1922

M. A. BENEAR

191

Scout