


Map No. K Sec. 21 Twp. 23 R. 13
Well No. 5 Sublime Farm
Atlantic Company

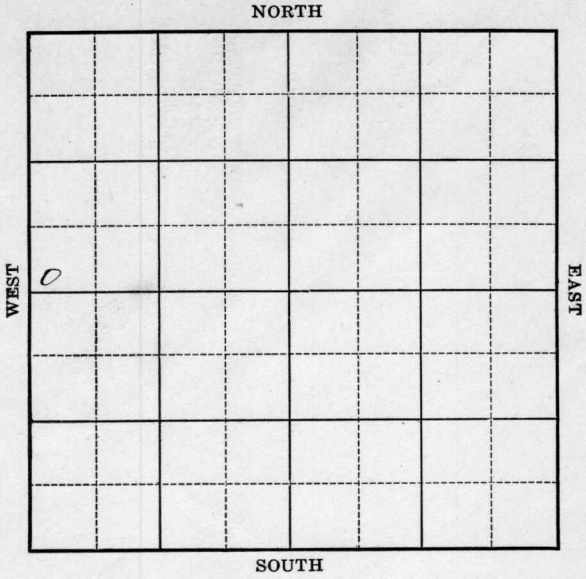

Location -----

Drilling Remarks:

RECORD

Cased ----- in. ----- ft.

Sand -----

Gas -----

Oil -----

Total Depth -----

Rig Up -----

Drilling Remarks:

PRODUCTION

1st 24 hrs. Nat. -----

1st 24 hrs. after shot -----

Gas ----- cu. ft.

Dry Hole -----

Abandoned -----

Map No. K17 Sec. 21 Twp. 23 R. 13

Well No. 5 Griffin

Atlantic Company

Contractor

FIRST REPORT

SECTION PLAT

----- Ft. from N. Line

200 Ft. from S. Line

----- Ft. from E. Line

200 Ft. from W. Line

Location -----

Rig up -----

Drilling and Remarks:

Rig up

RECORD

Cased ----- in., ----- ft.

Sand -----

Gas -----

Oil -----

Total Depth -----

PRODUCTION

1st 24 hrs. Nat. -----

1st 24 hrs. after shot -----

Gas ----- Cu. Ft.

Dry Hole -----

Abandoned -----

Date

FEB 18 1922

M. A. BENEAR

----- 191 -----

Scout

17 *Kans.*
Map No. _____ Sec. *21* Twp. *23* R. *13*

Well No. *5* *Gieplin*
atlantic _____ Company

Contractor

ABANDONED

SECTION PLAT

_____ Ft. from N. Line

200 Ft. from S. Line

_____ Ft. from E. Line

200 Ft. from W. Line

<i>0</i>			

Location _____

Rig up _____

Drilling and Remarks:

RECORD

Cased _____ in., _____ ft.

Sand _____

Gas _____

Oil _____

Total Depth _____

PRODUCTION

1st 24 hrs. Nat. _____

1st 24 hrs. after shot _____

Gas _____ Cu. Ft.

Dry Hole _____

Abandoned *2495*

Date

MAY 21 1922

M. A. BENEAR

191 _____

Scout