
Form 51-10M-7-20-CroMac

Map No. K Sec. 21 Twp. 23 R. 13

Well No. 6 Gubbins Farm

Atlantic Company

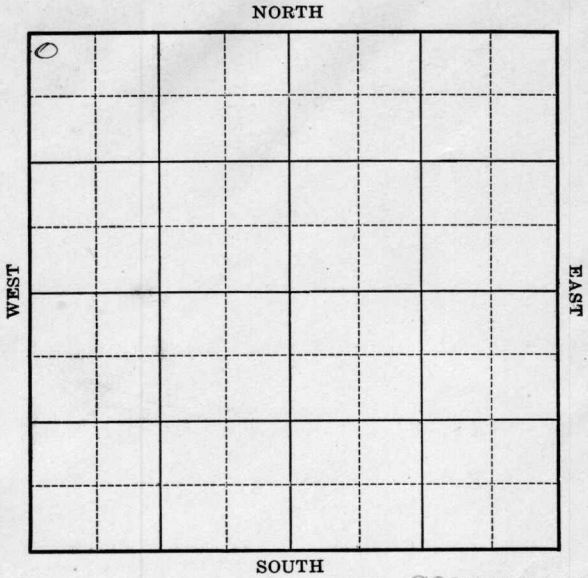

COMPLETED

Location

Drilling Remarks:

Rig Up

Drilling Remarks:

RECORD

Cased in. ft.

Sand

Gas

Oil

Total Depth

PRODUCTION

1st 24 hrs. Nat.

1st 24 hrs. after shot

Gas cu. ft.

Dry Hole

Abandoned

Form 252A 8M-11-20 PALACE-TULSA 4617

Map No. K Sec. 21 Twp. 23 R. 13

Well No. 6 Gaskins Farm


Atlantic Company

200 Ft. from N. Line

Ft. from S. Line

Ft. from E. Line

200 Ft. from W. Line

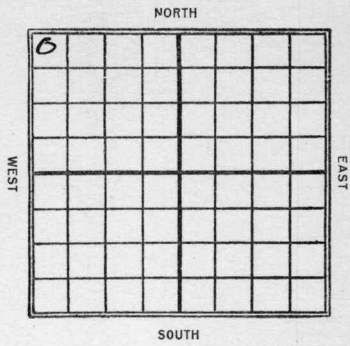

Date 1922	REPORT
2/18	Rog.
3/30	Dlg at 1310'
4/9	Sd 1740-62 — 6 qts
	Pumping 60 bbls
5/21	Sand 1700-18
	50/45 Bbls.

Form 26—1M—4-19—Mid-West

Map No. K17 Sec. 21 Twp. 23 R. 13


Well No. 2 Griblin

Atlantic Company

Contractor

FIRST REPORT

SECTION PLAT

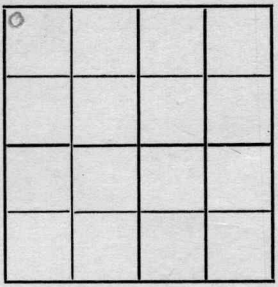

200 Ft. from N. Line

Ft. from S. Line

Ft. from E. Line

200 Ft. from W. Line

Location

Rig up

Drilling and Remarks:

R. O. G.

RECORD

Cased in., ft.

Sand

Gas

Oil

Total Depth

PRODUCTION

1st 24 hrs. Nat.

1st 24 hrs. after shot

Gas Cu. Ft.

Dry Hole

Abandoned

Date

FEB 18 1922

191

M. A. BENEAR

Scout

Form 26—1M—4-19—Mid-West

Map No. 17 Sec. 21 Twp. 23 R. 13


Well No. 6 Grubbs

Atlantic Pet. Company

Contractor

COMPLETED

SECTION PLAT

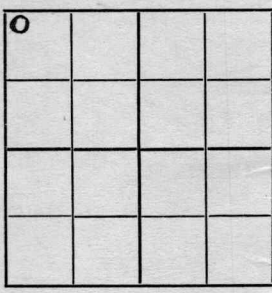

200 Ft. from N. Line

Ft. from S. Line

Ft. from E. Line

200 Ft. from W. Line

Location

Rig up

Drilling and Remarks:

Sand 1740-62
shot 60 qts
pumping 60
hrs.

RECORD

Cased in., ft

Sand

Gas

Oil

Total Depth

PRODUCTION

1st 24 hrs. Nat.

1st 24 hrs. after shot

Gas Cu. Ft

Dry Hole

Abandoned

Date

APR 19 1922 191

M. A. BENEAR Scout

Form 26—1M—4-19—Mid-West

Map No. 17 Kans Sec. 21 Twp. 23 R. 13

Well No. 6 Griffin

Atlantic Company

Contractor

FIRST REPORT

COMPLETED

Ft. from N. Line


Ft. from S. Line

Ft. from E. Line

Ft. from W. Line

Corrected card record

SECTION PLAT

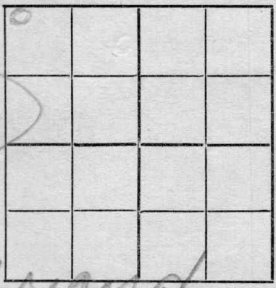

Location

Rig up

Drilling and Remarks:

sand 1700-18
50/45 7bls

RECORD

Cased in., ft.

Sand

Gas

Oil

Total Depth

PRODUCTION

1st 24 hrs. Nat.

1st 24 hrs. after shot

Gas Cu. Ft.

Dry Hole

Abandoned

Date

MAY 21 1922

191

M. A. BENEAR

Scout