

Section 21 Township 23-S Range 13-E

Well No. #4 Grablin (B)

Company Mid-Cont. Pet. Corp.

NORTH

						0	

WEST

EAST

SOUTH

Sec. 21 Twp. 23S R. 13E

Well No. #4 V. M. Griblin "B" Farm

Mid Continent Company


Jackman & Jackman Contractor

990 Ft. from N. Line

\_\_\_\_\_ Ft. from S. Line

990 Ft. from E. Line

\_\_\_\_\_ Ft. from W. Line

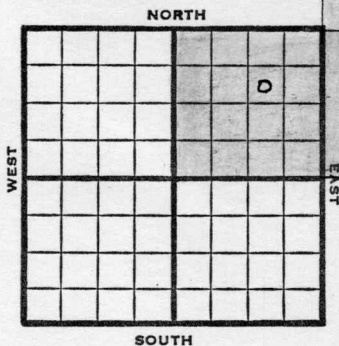

SW NE NE

1950

?

REPORT

5/18	Location notice	1800' Test	
6/7	Spudded 6-5-50 Set surface casing 8-5/8" at 20' with 10 sacks		(D R)
6/8	No report.		"
6/9	WOC.		"
6/12	TD 675 Drlg.		"
6/13	No report. Set 45' of 8 5/8" csg w/25 sax. TD 675 970 (Late report)		"
6/14	Drilling 1305 shale.		"
6/15	No report		"
6/16	5 1/2" csg set @ 1691' w/50 sax. WOC. TD 1692.		"
6/19	Bailing mud & drilling plug.		"
6/20	Drlg. 1713 w/cable tools. Slight show oil in last foot.		"
6/21	Preparing to acidize/ TD. 1716'.		"
6/22	Acidized with 2000 gal. Swabbing & testing.		"
6/23	Running tubing & rods.		"
6/26	Setting pumping unit.		"
6/27	Setting pumping unit.		"
6/28	Setting pumping unit.		"

1950

6/29 Setting pumping unit.

(D R)

6/28 8 5/8" @ 20

Miss 1690

5 1/2" @ 1692

TD 1716

5 gal oph

2000 acid

Comp 10 bopd

Completed

**COMPLETED**

Kansas

Map No. \_\_\_\_\_ Sec. 21 Twp. 23<sup>S</sup> R. 13E

Well No. 4 Grablin (B)

Mid-Continent Pet. Corp. Company

Jackman & Jackman Contractor

SW NE NE

SECTION PLAT

990 Ft. from N. Line

\_\_\_\_\_ Ft. from S. Line

990 Ft. from E. Line

\_\_\_\_\_ Ft. from W. Line

			0
FIRST REPORT			

Greenwood

Location X

Rig up \_\_\_\_\_

Drilling and Remarks:

RECORD

Cased \_\_\_\_\_ in., \_\_\_\_\_ ft.

Sand \_\_\_\_\_

Gas \_\_\_\_\_

Oil \_\_\_\_\_

Total Depth \_\_\_\_\_

PRODUCTION

1st 24 hrs. Nat. \_\_\_\_\_

1st 24 hrs. after shot \_\_\_\_\_

Gas \_\_\_\_\_ Cu. Ft.

Dry Hole \_\_\_\_\_

Abandoned \_\_\_\_\_

Date

MAY 24 1950

19

J. E. TYRA Scout

Map No. \_\_\_\_\_ Sec. 21 Twp. 23 R. 13E

Well No. 4 Griblin "B"

Mid-Continent Pet. Corp. Company

Contractor

SW NE NE


SECTION PLAT

990 Ft. from N. Line

\_\_\_\_\_ Ft. from S. Line

990 Ft. from E. Line

\_\_\_\_\_ Ft. from W. Line

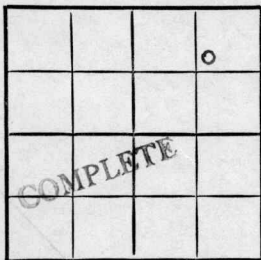

Greenwood County

Location \_\_\_\_\_

Rig up \_\_\_\_\_

Drilling and Remarks:

8 5/8" @ 20

Miss. 1690

5 1/2" @ 1692

TD 1716

5 gal. oph

2000 acid

Comp. 10 bopd

RECORD

Cased \_\_\_\_\_ in., \_\_\_\_\_ ft.

Sand \_\_\_\_\_

Gas \_\_\_\_\_

Oil \_\_\_\_\_

Total Depth 1716

PRODUCTION

1st 24 hrs. Nat. \_\_\_\_\_

1st 24 hrs. after shot \_\_\_\_\_

Gas \_\_\_\_\_ Cu. Ft.

Dry Hole \_\_\_\_\_

Abandoned \_\_\_\_\_

Date

JUN 28 1950

19

J. E. TYRA Scout