
Form 51 5M 7-22 9573

Map No. _____ Sec. 21 Twp. 23 R. 13

Well No. 8 Viola Gribling Farm

Atlantic Pet. Corp. Company

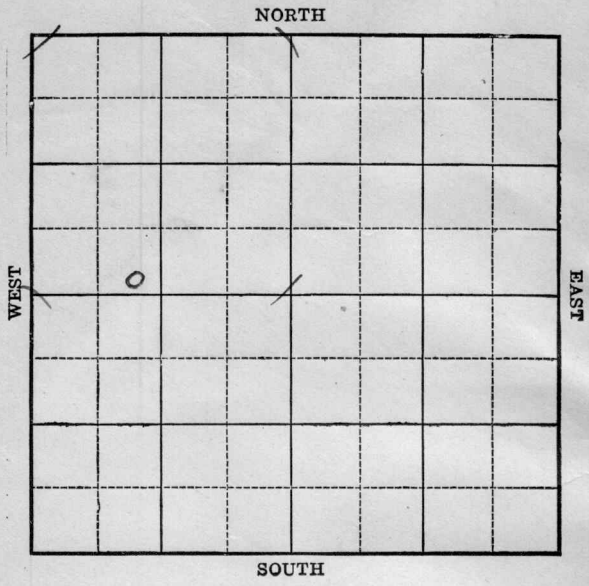

Location _____

Drilling Remarks:

Rig up _____

Drilling Remarks:

RECORD

Cased _____ in. _____ ft.

Sand _____

Gas _____

Oil _____

Total Depth _____

PRODUCTION

1st 24 hrs Nat. _____

1st 24 hrs. after shot _____

Gas _____ cu. ft.

Dry Hole _____

Abandoned _____

Form 252A 5M 8-21 PALACE-TULSA 6835

Map No. _____ Sec. 21 Twp. 23 R. 13

Well No. 8 Viola Gribbin Farm


Atlantic Pet. Co. Company

_____ Ft. from N. Line

200 Ft. from S. Line

_____ Ft. from E. Line

~~760~~ 818 Ft. from W. Line

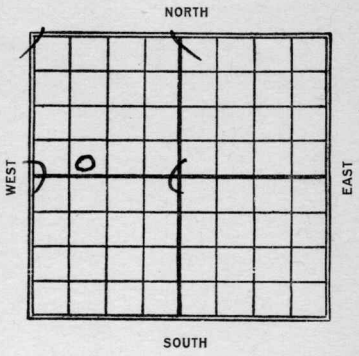

Date	REPORT
~~1923~~	
6/7	Location (N).
8/9	Pay 1690-1698 Shot 40 qt made 8 bbls

Form 26—1M Bks.—3-23—11959.

Map No. KANSAS 17 Sec. 21 Twp. 23 R. 13


Well No. B Griffin

Atlantic Ref. Company

Contractor

FIRST REPORT

SECTION PLAT

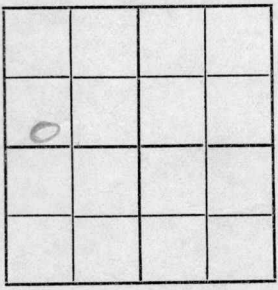

200 Ft. from N. Line

Ft. from S. Line

Ft. from E. Line

818 Ft. from W. Line

Location

Rig up

Drilling and Remarks:

Rig up

RECORD

Cased in., ft.

Sand

Gas

Oil

Total Depth

PRODUCTION

1st 24 hrs. Nat.

1st 24 hrs. after shot

Gas Cu. Ft.

Dry Hole

Abandoned

Date JUN 23 1923

M. A. BENEAR

192 Scout

Form 26—1M Bks.—3-23—11959.

Map No. 17 Kans Sec. 21 Twp. 23 R. 13


Well No. 2 Griffin

Atlantic Pet Company

Contractor

Completed

SECTION PLAT

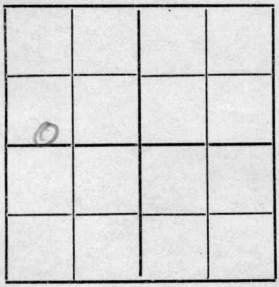

Ft. from N. Line

200 Ft. from S. Line

Ft. from E. Line

818 Ft. from W. Line

Location

Rig up

Drilling and Remarks:

Sep L 1666

Pay 1690-1698

4 0/8 Hole

RECORD

Cased in., ft.

Sand

Gas

Oil

Total Depth

PRODUCTION

1st 24 hrs. Nat.

1st 24 hrs. after shot

Gas Cu. Ft.

Dry Hole

Abandoned

Date 8/4 192 3

Scout