
Ellis

FORM 51-5M-6-29-PETROL

Map No. KANSAS Sec. 1 Twp. 13 R. 16 W

Well No. H. Heiland Farm

Davis etal Company

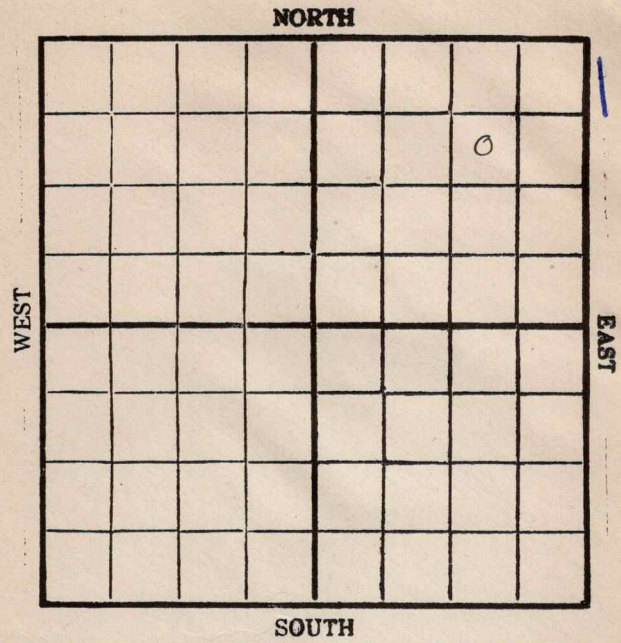

Location _____

Drilling Remarks

Rig Up _____

Drilling Remarks

RECORD

Cased _____ in. _____ ft.

Sand _____

Gas _____

Oil _____

Total Depth _____

PRODUCTION

1st 24 hrs. Nat. _____

1st 24 hrs. after shot _____

Gas _____ cu. ft. _____

Dry Hole _____

Abandoned _____

Ellis

FORM 252A-5M-12-28-PETROL

Map No. KANSAS Sec. 1 Twp. 13 R. 16 W

Well No. 4 - Weiland Farm


Davis, etal Company

990 Ft. from N. Line

Ft. from S. Line

990 Ft. from E. Line

Ft. from W. Line

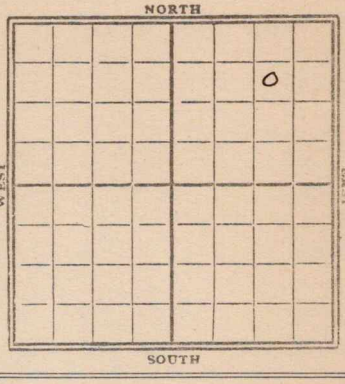

1929

Date	REPORT		
9/18	Cellar		
9/25	—		
10/2	Rdy Rig		
10/9	Rig		
10/16	—		
10/23	—		
10/30	Rigg up		
11/6	—		
11/13	—		
11/20	Rig up & S.D.		
11/27	Rigged up		
12/4	—		
12/11	—	2/12	—
12/18	—	2/19	—
12/23	—	2/26	—
12/30	—	3/5	—
1930		3/12	—
1/8	—	3/19	—
1/15	—	3/26	—
1/22	—	4/2 - Rigging up	
1/29	—	4/9 - Drlg 4408	
2/5	—		

739647

4/16 - Drlg. 1390'

4/23 - " 2435 1/4 gas
2408-20

4/30 - S.D. 2735'

5/7 - Show oil 2718-
show oil 2900'-
6" - 2980 - Drlg. at
3000'

5/14 - 3004-08' 4 bbls
oil per hr. 3078-88
4 bbls oil per hr.
Drlg. out.

5/21 - Sand 3004-83
TD 3083
Sinclair Oil
Corp.

Form 26—1M Bks.—9-26


Map No. KANSAS Sec. 1 Twp. 13 R. 16 W

Well No. 4 Heiland

Davis & Dale Company

Contractor

SECTION PLAT

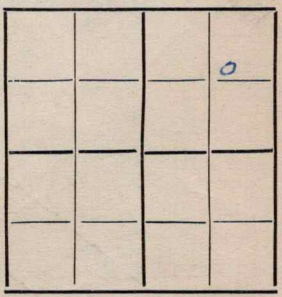

990 Ft. from N. Line

Ft. from S. Line

990 Ft. from E. Line

Ft. from W. Line

FIRST REPORTS

Location

Rig up

Drilling and Remarks:

Cellar

RECORD

Cased in., ft.

Sand

Gas

Oil

Total Depth

PRODUCTION

1st 24 hrs. Nat.

1st 24 hrs. after shot

Gas Cu. Ft.

Dry Hole

Abandoned

Date

SEP 18 1929 192

S. J. LEWIS Scout

Form 26—1M Bks.—9-28


Map No. KANSAS Sec. 1 Twp. 13 R. 16 W

Well No. 4 Streiland

Davis & Dale Company

Contractor

SECTION PLAT

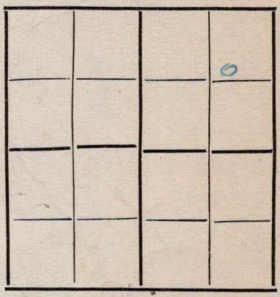

990 Ft. from N. Line

Ft. from S. Line

990 Ft. from E. Line

Ft. from W. Line

COMPLETED

Location

Rig up

Drilling and Remarks:

Swabbed 90 BBLs

RECORD

Cased in., ft.

Sand 3004 - 08

Gas

Oil

Total Depth 3085

PRODUCTION

1st 24 hrs. Nat.

1st 24 hrs. after shot

Gas Cu. Ft.

Dry Hole

Abandoned

Date

MAY 21 1930

192

S. J. LEWIS Scout