


Map No. *Kan* Sec. *16* Twp. *27* R. *6*

Well No. *J Reynolds* Farm
Phillips Pet Company

NORTH

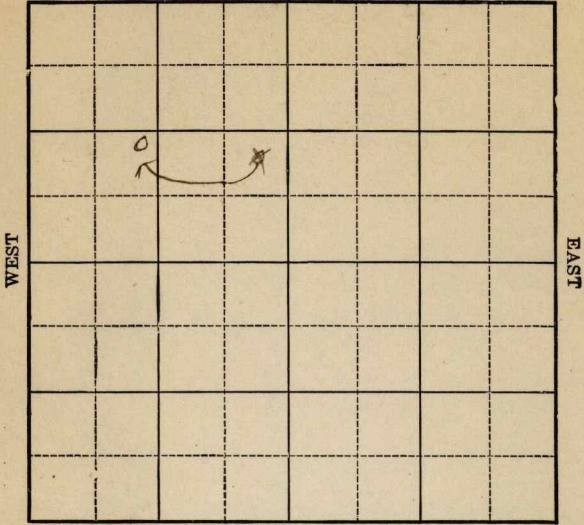

SOUTH

Location _____
Drilling Remarks _____

Rig Up _____
Drilling Remarks _____

RECORD

PRODUCTION


Cased _____ in. _____ ft.
Sand _____
Gas _____
Oil _____
Total Depth _____

1st 24 hrs. Nat. _____
1st. 24 hrs. after shot _____
Gas _____ cu. ft.
Dry Hole _____
Abandoned _____

Map No. Kan Sec. 16 Twp. 27 R. 6

Well No. 1 Reynolds Farm
Phillips Pet Co Company

 Ft. from N. Line
1020 Ft. from S. Line
~~300~~ Ft. from E. Line
1020 Ft. from W. Line
C

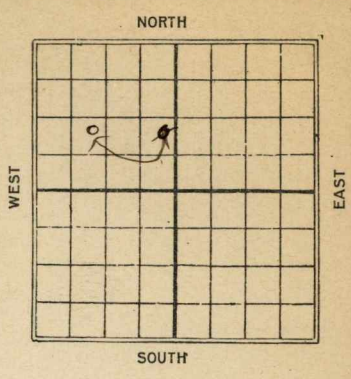

Date	REPORT
1925	
7/3	Location
7/10	_____
7/17	Rig
7/24	_____
7/31	150'
8/7	875'
8/14	1585'
8/20	1845'
8/27	2050'
9/3	2290'
9/11	Top Lime 2760' show Oil 2905' 10' Oil.
9/19	Top Lime 2760' Sand 2899-2905 T.D. 2909 40 gals 12 bbls

Map No. 11 Kansas Sec. 16 Twp. 27 R. 6

Well No. Phillip Raynolds 289 @

Company

Contractor

FIRST REPORTS

SECTION PLAT

----- Ft. from N. Line

1020 Ft. from S. Line

300 Ft. from E. Line

----- Ft. from W. Line

	6		

Location

Rig up -----

Drilling and Remarks:

RECORD

Cased ----- in., ----- ft.

Sand -----

Gas -----

Oil -----

Total Depth -----

PRODUCTION

1st 24 hrs. Nat. -----

1st 24 hrs. after shot -----

Gas ----- Cu. Ft.

Dry Hole -----

Abandoned -----

Date

JUL 3

1925

CHAS. L. SHERWOOD

192

Scout

Map No. *N. Sands* Sec. *16* Twp. *27* R. *6*

Well No. *Keyhole*

Phillips Pet Co Company

Contractor

SECTION PLAT

----- Ft. from N. Line

1070 Ft. from S. Line

----- Ft. from E. Line

1070 Ft. from W. Line

	<i>OK</i>		

CORRECTION

Location -----

Rig up -----

Drilling and Remarks:

chg location to above,

RECORD

Cased ----- in., ----- ft.

Sand -----

Gas -----

Oil -----

Total Depth -----

PRODUCTION

1st 24 hrs. Nat. -----

1st 24 hrs. after shot -----

Gas ----- Cu. Ft.

Dry Hole -----

Abandoned -----

Date **JUL 17 1925**

CHAS. L. SHERWOOD

Butter Co

Map No. KANSAS Sec. 16 Twp. 27 R. 6

Well No. 1 Reynolds

Phillips pet Co Company

Contractor

COMPLETED

SECTION PLAT

_____ Ft. from N. Line

1070 Ft. from S. Line

_____ Ft. from E. Line

1070 Ft. from W. Line

Location _____

Rig up _____

Drilling and Remarks:

2760'

40' 12 bhs.

RECORD

Cased _____ in., _____ ft.

Sand 2899-2905

Gas _____

Oil _____

Total Depth 2909'

PRODUCTION

1st 24 hrs. Nat. _____

1st 24 hrs. after shot _____

Gas _____ Cu. Ft.

Dry Hole _____

Abandoned _____

Date

SEP 19 1925

192

CHAS. L. SHERWOOD

Scout