

KANSAS

Ellis

Sec. 1 Twp. 13 R. 16W ✓

Well No. #4 Weiland "B" Farm _____

Solar Oil

Company _____


Fairport Pool

330' Ft. from N. Line

_____ Ft. from S. Line

_____ Ft. from E. Line

330' Ft. from W. Line

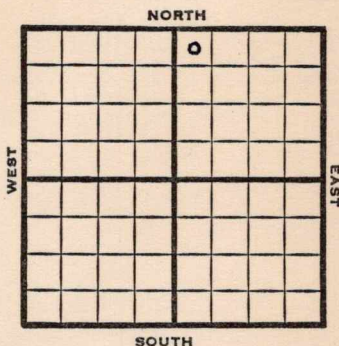

NW NE

1949

Elev. 1863'

REPORT

5/18	Location
5/25	"
6/1	"
6/7	8" @ 939' Drlg. 1650'
6/15	Lansing 2989' Arb. 3255-65' TD 3265' 5" @ 3257'
6/21	"
6/28	"
7/6	TD 3266' 500 acid
7/12	"
7/20	Completed Arb. 3255' 5" @ 3257' Pump 30 oil & 60 W Pot. 37.0 Grav. TD 3266'

COMPLETED

Map No. _____ Sec. 1 Twp. 13 R. 16W

Well No. 4 Weiland "B"

Solar Oil Company

Contractor

NW NE

FIRST REPORT
SECTION PLAT

330 Ft. from N. Line

_____ Ft. from S. Line

_____ Ft. from E. Line

330 Ft. from W. Line

		o	

Ellis County

Location X

Rig up _____

Drilling and Remarks:

RECORD

Cased _____ in., _____ ft.

Sand _____

Gas _____

Oil _____

Total Depth _____

PRODUCTION

1st 24 hrs. Nat. _____

1st 24 hrs. after shot _____

Gas _____ Cu. Ft.

Dry Hole _____

Abandoned _____

Date

MAY 18 1949 19

S. J. LEWIS Scout

Map No. K71 Sec. 1 Twp. 13 R. 16W

Well No. 4 Weiland "B"

Solar Oil Company

COMPLETE

Contractor

NW NE

E. 1, 1963
SECTION PLAT

		0	

330 Ft. from N. Line

_____ Ft. from S. Line

_____ Ft. from E. Line

330 Ft. from W. Line

Ellis County

Location _____

Rig up _____

Drilling and Remarks:

Core 3255

5" 3257

Run 30 oil + 60W bit

87-2-91

RECORD

Cased _____ in., _____ ft.

Sand _____

Gas _____

Oil _____

Total Depth 3266

PRODUCTION

1st 24 hrs. Nat. _____

1st 24 hrs. after shot _____

Gas _____ Cu. Ft.

Dry Hole _____

Abandoned _____

Date

JUL 20 1949

19

S. J. LEWIS

Scout