

KANSAS

Butler

Section 16 Township 27 Range 6E

Well No. 1 Seglem

Company Dunn & Strait

Misc.

NORTH

	0						

WEST

EAST

SOUTH

KANSAS

Butler

Sec. 16 Twp. 27 R. 6-E

Well No. #1 Seglem Farm  
Dunn & Strait Company

Miscellaneous


990' Ft. from N. Line

\_\_\_\_\_ Ft. from S. Line

\_\_\_\_\_ Ft. from E. Line

990' Ft. from W. Line

SE NW NW

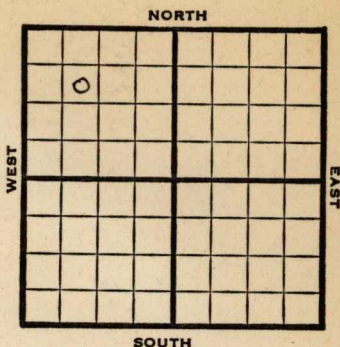

1947 Elev. 1400' REPORT

11/12 Loc. All wells abandoned

11/19 "

11/25 "

12/3 "

12/10 "

12/17 "

12/30 13" @ 715'  
Drlg. 755'

1948 1/7 Drlg. 1500'

1/14 10" @ 1602'  
Lansing 1805'  
Drlg 1925'

1/21 KC 2125'  
8" @ 2260'  
Drlg. 2290'

1/26 Mississippi 2758'  
Drlg 2899'

2/4 Viola 3139'  
5" @ 3130'

OVER

1948

2/11

Viola 3135'

5" @ 3130'

500 acid

Pump 40 oil / 50% W pot

Gr. 38.0

TD 3136'

Comp.

**COMPLETED**

Map No. \_\_\_\_\_ Sec. 16 Twp. 27 R. 6E

Well No. 1 Seglem

Dunn & Strait Company

FIRST REPORT Contractor

SE NW NW


SECTION PLAT

990 Ft. from N. Line

\_\_\_\_\_ Ft. from S. Line

\_\_\_\_\_ Ft. from E. Line

990 Ft. from W. Line

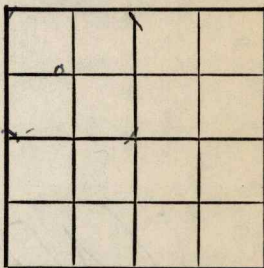

Butler County

Location X

Rig up \_\_\_\_\_

Drilling and Remarks:

All wells abandoned

RECORD

Cased \_\_\_\_\_ in., \_\_\_\_\_ ft.

Sand \_\_\_\_\_

Gas \_\_\_\_\_

Oil \_\_\_\_\_

Total Depth \_\_\_\_\_

PRODUCTION

1st 24 hrs. Nat. \_\_\_\_\_

1st 24 hrs. after shot \_\_\_\_\_

Gas \_\_\_\_\_ Cu. Ft.

Dry Hole \_\_\_\_\_

Abandoned \_\_\_\_\_

Date

NOV 12 1947 19

S. J. LEWIS

Scout

