KANSAS Ellis


FORM 51 25M 3-49 PETROL

Section 1 Township 13 Range 16-W

Well No. #7 Weiland "B"

Company Solar Oil

Fairport Pool

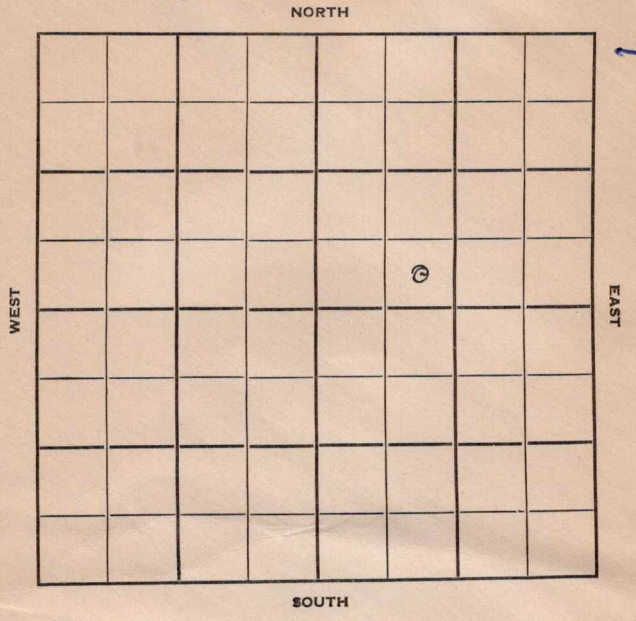

7

FORM 252-B
10M 9-49 PETROL

Ellis

KANSAS

Sec. 1 Twp. 13 R. 16W

Well No. #7 Weiland "B" Farm

Solar Oil Company

Pickrell Drlg. Contractor

Fairport Pool


_____ Ft. from N. Line

330' Ft. from S. Line

_____ Ft. from E. Line

990' Ft. from W. Line

SE SW NE

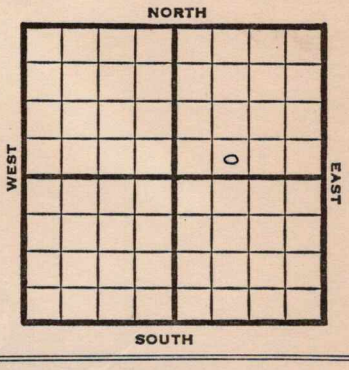

1950	Elev. 1877' REPORT
3/8	Spud 3-1-50 Anhy 930-78 8" @ 941' Drlg. 1501'
3/29	TD 3280' 8"@ 941' 5"@ 3273' Topeka 2732' Lans 3009' Arb 3271' P 50 BOPD Comp
	COMPLETED

Form 26 200 Bks. 11-49 Petrol Kansas

Fairport Pool

Map No. _____ Sec. 1 Twp. 13 R. 16W


Well No. 7 Weiland "B"

Solar Oil Company

Pickrell Drlg. Contractor

SE SW NE El. 1877

SECTION PLAT

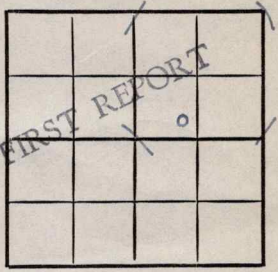

_____ Ft. from N. Line

330 Ft. from S. Line

_____ Ft. from E. Line

990 Ft. from W. Line

Ellis County

Location _____

Rig up _____

Drilling and Remarks:

Spud 3-1-50
Anhy 930-78
8" @ 941
drlg. 1501

RECORD

Cased _____ in., _____ ft.

Sand _____

Gas _____

Oil _____

Total Depth _____

PRODUCTION

1st 24 hrs. Nat. _____

1st 24 hrs. after shot _____

Gas _____ Cu. Ft.

Dry Hole _____

Abandoned _____

Date

MAR 8 1950 19 J. E. TYRA Scout

Form 26 200 Bks. 11-49 Petrol

Kansas

Fairport Pool

Map No. _____ Sec. 1 Twp. 13 R. 16W

Well No. 7 Weiland "B"


Solar Oil Company

Contractor

SE SW NE

El. 1877

SECTION PLAT

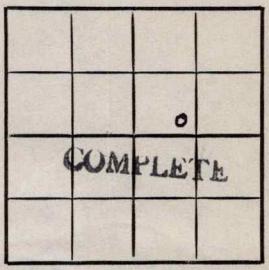

_____ Ft. from N. Line

330 Ft. from S. Line

_____ Ft. from E. Line

990 Ft. from W. Line

Ellis County

Location _____

Rig up _____

Drilling and Remarks:

8" @ 941

5" @ 3273

Topeka 2732

Lans 3009

Arb 3271

P 50 BOPD

RECORD

Cased _____ in., _____ ft.

Sand _____

Gas _____

Oil _____

Total Depth 3280

PRODUCTION

1st 24 hrs. Nat. _____

1st 24 hrs. after shot _____

Gas _____ Cu. Ft.

Dry Hole _____

Abandoned _____

Date

MAR 29 1950

19

J. E. TYRA

Scout