



Map No. **KANSAS** Sec. 17 Twp. 27 R. 6


Well No. 1-Getter Farm  
Richmond Drlg Company

330 Ft. from N. Line

\_\_\_\_\_ Ft. from S. Line

330 Ft. from E. Line

\_\_\_\_\_ Ft. from W. Line

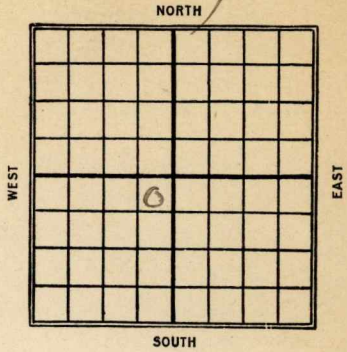

1927

Date	REPORT
12/7	Rig up
12/14	Rigging up
12/21	Drlg 740
12/29	" 1000
<u>1928</u>	
1/5	Drlg 1600-
1/11	" 1865
1/18	sdy shale 2695-2710. drilling 2720-
1/26	Drlg 2950
2/11	sdy shale 2695-2710
	top lime 2747-shewail
	Base line 3050
	Top Wilcox 3117-30
	HFW- 279. 3130

*Butler*

11 **KANSAS** Map No. ----- Sec. *17* Twp. *27* R. *6*

Well No. *1* *Setter* -----  
*Richmond Oly Co* ----- Company

----- Contractor

**FIRST REPORTS**

**SECTION PLAT**

*330* ----- Ft. from N. Line

----- Ft. from S. Line

*330* ----- Ft. from E. Line

----- Ft. from W. Line

	o		

Location -----

Rig up ----- ✓

Drilling and Remarks:

**RECORD**

Cased ----- in., ----- ft.

Sand -----

Gas -----

Oil -----

Total Depth -----

**PRODUCTION**

1st 24 hrs. Nat. -----

1st 24 hrs. after shot -----

Gas ----- Cu. Ft.

Dry Hole -----

Abandoned -----

Date

**DEC 7 1927 CHAS. L. SHERWOOD**

192

Scout

Butter

Map No. **KANSAS** Sec. 17 Twp. 27 R. 6

Well No. 1 *Setton*

*Richmond Oil Co* Company

Contractor

**COMPLETED**

**SECTION PLAT**

*330* Ft. from N. Line

Ft. from S. Line

*330* Ft. from E. Line

Ft. from W. Line

	o		

**ABANDONED**

Location -----

Rig up -----

Drilling and Remarks:

*Sdy shale 2695-2710*

*Top lim 2747-Show*

*Boz lim 3080*

*Top Wilcox 3117-30*

*AFW DQg*

**RECORD**

Cased ----- in., ----- ft.

Sand -----

Gas -----

Oil ----- *3,30*

Total Depth ----- *3,30*

**PRODUCTION**

1st 24 hrs. Nat. -----

1st 24 hrs. after shot -----

Gas ----- Cu. Ft.

Dry Hole

Abandoned

Date

**FEB 1 1928**

**CHAS. L. SHERWOOD**

192

Scout