



Map No. N. Sec. 21 Twp. 23 R. 13

Well No. 1 Jones Farm  
Schmitt et al. Company

NORTH

200 Ft. from N. Line


\_\_\_\_\_ Ft. from S. Line

200 Ft. from E. Line

\_\_\_\_\_ Ft. from W. Line

WEST

EAST

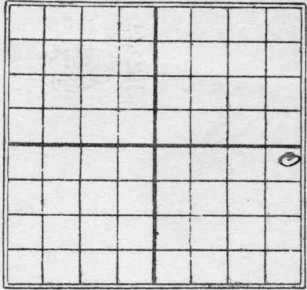

SOUTH

Date

REPORT

1922

1/3

Spudding  
1<sup>st</sup> shot 60 gts 2<sup>nd</sup> shot  
90 gts looks dry T.D. 1766?  
Log 1739

3/12


1739-1766 T.D. 1766  
Shot two times 1<sup>st</sup> shot 60 gts  
2<sup>nd</sup> " 90 "  
Pumping 3 Bbls.

Map No. 17 Sec. 21 Twp. 23 R. 13

Well No. 1 Jones Farm  
Smith et al. Company

Date Started \_\_\_\_\_ Ft. from N 200 S \_\_\_\_\_ E 200 W \_\_\_\_\_ line

**NORTH** Kansas

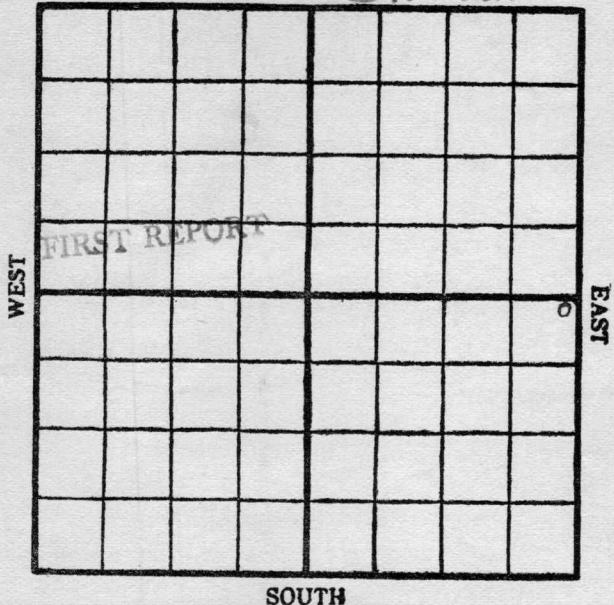

Cased \_\_\_\_\_ In. \_\_\_\_\_ Ft.

Sand \_\_\_\_\_

Pay { Gas \_\_\_\_\_

      { Oil \_\_\_\_\_

Total Depth \_\_\_\_\_

Production Remarks

Condition of Well on this date \_\_\_\_\_

Spudding

M. A. BENDAR

Scout

Map No. K17 Sec. 21 Twp. 23 R. 13

Well No. 1 Jones Farm  
Smith et al Company

Contractor

**COMPLETED SECTION PLAT**

200 Ft. from N. Line

----- Ft. from S. Line

200 Ft. from E. Line

----- Ft. from W. Line

			0

Location -----

Rig up -----

Drilling and Remarks:

*shot two times*  
*1st shot 60 gts*  
*2nd " 90 "*  
*pumping*  
*3 lbs.*

**RECORD**

Cased ----- in., ----- ft.

Sand -----

Gas -----

Oil 1739-1766

Total Depth 1766

**PRODUCTION**

1st 24 hrs. Nat. -----

1st 24 hrs. after shot -----

Gas ----- Cu. Ft.

Dry Hole -----

Abandoned -----

Date

MAR 12 1922

M. A. BENEAR

191

Scout