


Map No. _____ Sec. 21 Twp. 23 R. 13

Well No. # 2 Jones Farm _____
R. G. Gillespie Company _____

NORTH

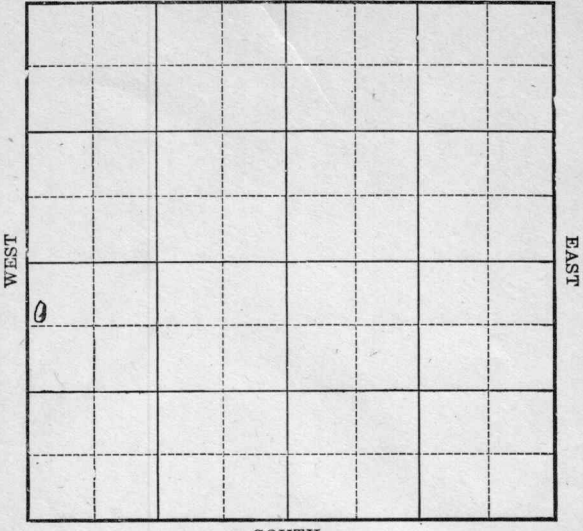

SOUTH

Location _____

Rig Up _____

Drilling Remarks:

Drilling Remarks:

RECORD

PRODUCTION

Cased _____ in. _____ ft.

1st 24 hrs. Nat. _____

Sand _____

1st 24 hrs. after shot _____

Gas _____

Gas _____ cu. ft.

Oil _____

Dry Hole _____

Total Depth _____

Abandoned _____

Map No. K17 Sec. 21 Twp. 23 R. 13

Well No. 2 Jones

R. G. Gillespie Company

Contractor

FIRST REPORT

SECTION PLAT

550' Ft. from N. Line

----- Ft. from S. Line

----- Ft. from E. Line

200' Ft. from W. Line

Location -----

Rig up -----

Drilling and Remarks:

Location

RECORD

Cased ----- in., ----- ft.

Sand -----

Gas -----

Oil -----

Total Depth -----

PRODUCTION

1st 24 hrs. Nat. -----

1st 24 hrs. after shot -----

Gas ----- Cu. Ft.

Dry Hole -----

Abandoned -----

Date

MAR 26 1922

191

M. A. BENEAR

Scout

Map No. *Map 17* Sec. *21* Twp. *23* R. *13*

Well No. *2 Jones*

R. G. Gillespie Company

Contractor

COMPLETED

SECTION PLAT

550 Ft. from N. Line

----- Ft. from S. Line

----- Ft. from E. Line

200 Ft. from W. Line

RETURNED TO THE COMPANY

Location -----

Rig up -----

Drilling and Remarks:

Top Line 1754

RECORD

Cased ----- in., ----- ft.

Sand -----

Gas -----

Oil *1667-89*

Total Depth *1679*

PRODUCTION

1st 24 hrs. Nat. *100 bbls*

1st 24 hrs. after shot -----

Gas ----- Cu. Ft.

Dry Hole -----

Abandoned -----

Date

MAY 21 1922

M. A. BENEAR

191

Scout

Formerly reported in *SW 1/4*
550N-200W. Is this correct

INDEX

RECORD

Returned

Cards

Tracing

J. S. C. map

Frantz map

Moody map

Frantz plat book

Moody plat book