


28075

Sec. 21 Twp. 23S R. 13E
D. Jones No.
Gillespie Company
Elev. T. D.
Log No. 1 thru 8

#1 - N. R.

27033

#2 - comm - 3-31-22 12'' - 387
comp - 5-2-22 10-955
8-1440
6-1654

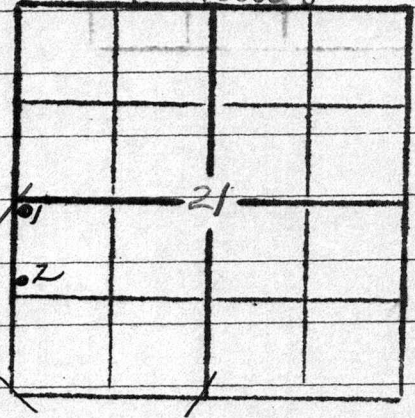

- sand 0-8
- L 20
- sh 120
- L 130
- sh 250
- L 358
- sh 330
- wtcs 365
- sh. 370
- S 387
- sh 575
- L 595 *Sueti*
- sh 600
- L 660
- sh 690
- L 845
- sh 875
- L 955
- sh 965
- L 1015
- sh 1150
- L 1155
- sh 1170
- L 1185
- sh 1245
- L 1250
- sh 1280
- S 1300
- sh 1654
- miss 1667
- ails 1689 *5*

Joel