
Form 51 5M 11-23 13896

Map No. K Sec. 21 Twp. 23 R. 13

Well No. 8 Janes Farm

R. G. Gillespie Company

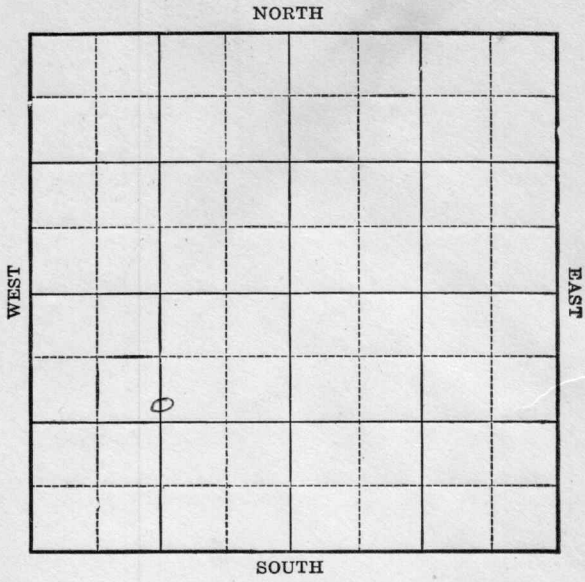

Location _____

Drilling Remarks:

Rig Up _____

Drilling Remarks:

RECORD

Cased _____ in. _____ ft.

Sand _____

Gas _____

Oil _____

Total Depth _____

PRODUCTION

1st 24 hrs. Nat. _____

1st 24 hrs. after shot _____

Gas _____ cu. ft.

Dry Hole _____

Abandoned _____

Form 252A 5M 4-22 8765

Map No. 16 Sec. 21 Twp. 23 R. 13

Well No. E Jones Farm


R L Gillespie Company

1120 Ft. from N. Line

_____ Ft. from S. Line

_____ Ft. from E. Line

1320 Ft. from W. Line

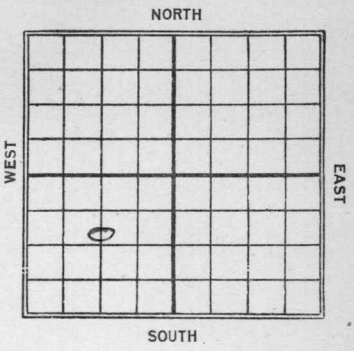

C.

Date	REPORT
1924	
1/15	Rig up
7/16	Tap'd. 1683
	Pay. 1713 - 23
1925	40/15
8/14	Compl.

Form 26—1M—4-19—Mid-West

Map No. KANSAS Sec. 21 Twp. 23 R. 13


Well No. 3 Jones

R. G. V. Gillespie Company

Contractor

FIRST REPORT

SECTION PLAT

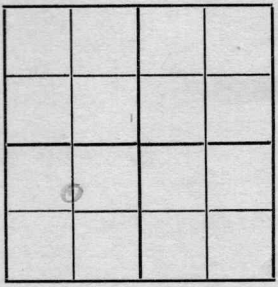

1120 Ft. from N. Line

Ft. from S. Line

Ft. from E. Line

1320 Ft. from W. Line

Location

Rig up

Drilling and Remarks:

RECORD

Cased in., ft.

Sand

Gas

Oil

Total Depth

PRODUCTION

1st 24 hrs. Nat.

1st 24 hrs. after shot

Gas Cu. Ft.

Dry Hole

Abandoned

Date

JAN 15 1924 191

M. A. RENEAR

Form 26—1M Bks.—3-23—11959.

Map No. 17 KANSAS Sec. 21 Twp. 22 R. 13

Well No. 8 Gore

R. D. Gillespie Company

Contractor

COMPLETED


1170 Ft. from N. Line

Ft. from S. Line

Ft. from E. Line

1320 Ft. from W. Line

SECTION PLAT

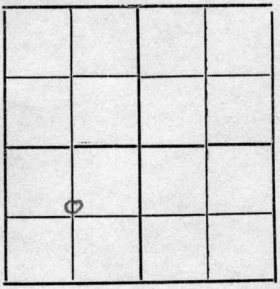

Location

Rig up

Drilling and Remarks:

Top Lin 1683'

Pay 1713-23'

4a/15 bbls

RECORD

Cased in., ft.

Sand

Gas

Oil

Total Depth

PRODUCTION

1st 24 hrs. Nat.

1st 24 hrs. after shot

Gas Cu. Ft.

Dry Hole

Abandoned

Date

AUG 14 1925

192

CHAS. L. SHERWOOD

Scout