

Greenwood

Map No. *15* Sec. *21* Twp. *23* R. *13*

Well No. *9 - Jones* Farm
Superior Oil Company


..... Ft. from N. Line

1070 Ft. from S. Line

..... Ft. from E. Line

1070 Ft. from W. Line

1927

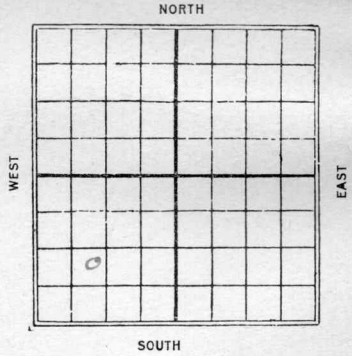

Date

REPORT

<i>3/9</i>	<i>Rigging up</i>
<i>3/16</i>	<i>Spudding</i>
<i>3/24</i>	<i>Drlg 360</i>
<i>3/30</i>	<i>" 625</i>
<i>4/7</i>	<i>" 685</i>
<i>4/13</i>	<i>" 1025</i>
<i>4/20</i>	<i>" 1200</i>
<i>4/27</i>	<i>" 1450</i>
<i>5/5</i>	<i>Top line 1667</i>
	<i>Sand 1672-1686</i>
	<i>60 gts / 15 bbls</i>
	<i>F.D. 1686</i>

Sherwood

17 KANSAS Map No. _____ Sec. *21* Twp. *23* R. *13*

Well No. *9 Jones* _____

Superior Oil Co _____ Company

_____ Contractor

FIRST REPORTS


_____ Ft. from N. Line

1070 Ft. from S. Line

_____ Ft. from E. Line

1070 Ft. from W. Line

SECTION PLAT

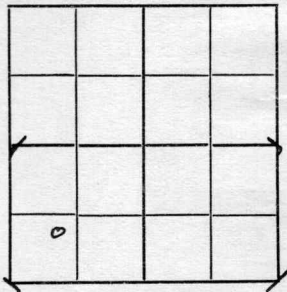

Location _____

Rig up *Rigging up*

Drilling and Remarks:

Formerly owned by H. S. Gibbs

RECORD

Cased _____ in., _____ ft.

Sand _____

Gas _____

Oil _____

Total Depth _____

PRODUCTION

1st 24 hrs. Nat. _____

1st 24 hrs. after shot. _____

Gas _____ Cu. Ft.

Dry Hole _____

Abandoned _____

Date

MAR 9 1927

CHAS. L. SHERWOOD

Sherwood

Map No. 17 KANSAS Sec. 21 Twp. 23 R. 13

Well No. 9 Jones

Superior Oil Co Company

Contractor

COMPLETED

SECTION PLAT

----- Ft. from N. Line

1070 Ft. from S. Line

----- Ft. from E. Line

1070 Ft. from W. Line

0			

Location -----

Rig up -----

Drilling and Remarks:

Top line 1667'
Sand 1672-1686'
607 15 Bls

RECORD

Cased ----- in., ----- ft.
Sand -----
Gas -----
Oil -----
Total Depth 1686'

PRODUCTION

1st 24 hrs. Nat. -----
1st 24 hrs. after shot -----
Gas ----- Cu. Ft.
Dry Hole -----
Abandoned -----

Date

MAY 5 1927

CHAS. L. SHERWOOD