
Form 51 5M 2-22 8411

Map No. K Sec. 21 Twp. 23 R. 13

Well No. 3 Jones Farm

Smith Etal Company

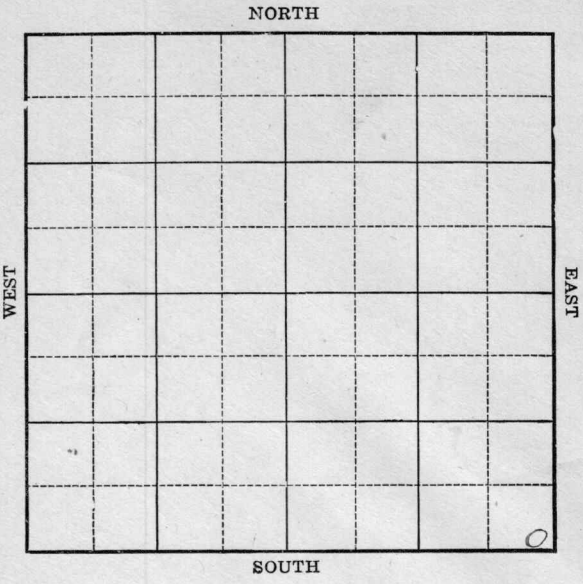

FIRST REPORT

Location _____

Drilling Remarks:

Rig Up _____

Drilling Remarks:

RECORD

Cased _____ in. _____ ft.

Sand _____

Gas _____

Oil _____

Total Depth _____

PRODUCTION

1st 24 hrs. Nat. _____

1st 24 hrs, after shot _____

Gas _____ cu. ft.

Dry Hole _____

Abandoned _____

Form 252A 5M 8-21 PALACE-TULSA 6835

Map No. _____ Sec. 21 Twp. 23 R. 13

Well No. # 2 Jones Farm


Smith et al Company

_____ Ft. from N, Line

200 Ft. from S. Line

200 Ft. from E. Line

_____ Ft. from W. Line

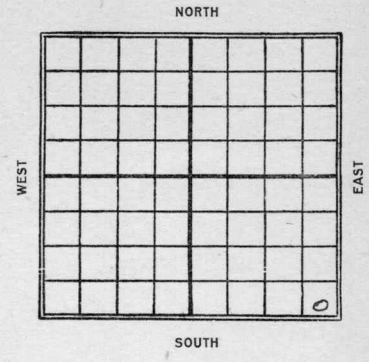

Date 1922	REPORT
4/19	Rig
7/15	1708-63 TD 1763
	50 qts 15 Bbls

Form 26—1M—4-19—Mid-West

Map No. 17 Sec. 31 Twp. 33 R. 13


Well No. 2- Jones

Smith et al Company

Contractor

FIRST REPORT

SECTION PLAT

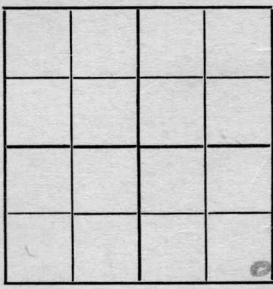

Ft. from N. Line

2310 Ft. from S. Line

2310 Ft. from E. Line

Ft. from W. Line

Location

Rig up

Drilling and Remarks:

Rig

RECORD

Cased in., ft

Sand

Gas

Oil

Total Depth

PRODUCTION

1st 24 hrs. Nat.

1st 24 hrs. after shot

Gas Cu. Ft

Dry Hole

Abandoned

Date

APR 19 1922 191

M. A. BENEAR Scout

Form 26—1M—4-19—Mid-West

Map No. Kas 17 21 Sec. ____ Twp. 23 R. 13


Well No. 2 Jones

Smith Eltd ____ Company

Sold to Gillespie ____ Contractor

COMPLETED

SECTION PLAT

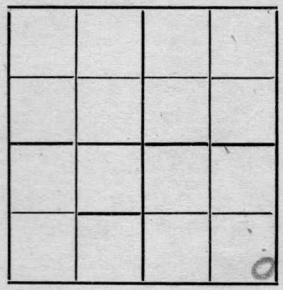

____ Ft. from N. Line

200 Ft. from S. Line

200 Ft. from E. Line

____ Ft. from W. Line

Location ____

Rig up ____

Drilling and Remarks:

shot. 60 qts

RECORD

Cased ____ in., ____ ft.

Sand ____

Gas ____

Oil 1707-63

Total Depth 1763

PRODUCTION

1st 24 hrs. Nat. ____

1st 24 hrs. after shot 15

Gas ____ Cu. Ft.

Dry Hole ____

Abandoned ____

Date

JUL 15 1922

____ 191____

M. A. BENEAR ____ Scout