


Map No. \_\_\_\_\_ Sec. 21 Twp. 23 R. 13  
Well No. # 3 Jones Farm \_\_\_\_\_  
R. J. Gillespie Company

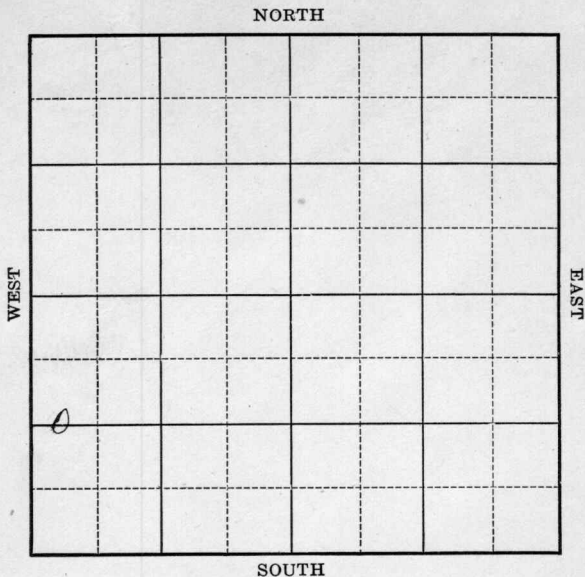

Location \_\_\_\_\_

Drilling Remarks:

Rig Up \_\_\_\_\_

Drilling Remarks:

RECORD

Cased \_\_\_\_\_ in. \_\_\_\_\_ ft.

Sand \_\_\_\_\_

Gas \_\_\_\_\_

Oil \_\_\_\_\_

Total Depth \_\_\_\_\_

PRODUCTION

1st 24 hrs. Nat. \_\_\_\_\_

1st 24 hrs. after shot \_\_\_\_\_

Gas \_\_\_\_\_ cu. ft.

Dry Hole \_\_\_\_\_

Abandoned \_\_\_\_\_

Map No. \_\_\_\_\_ Sec. 21 Twp. 23 R. 13


Well No. #3 Jones Farm \_\_\_\_\_  
PJ Gillespie Company

\_\_\_\_\_ Ft. from N. Line

1320 Ft. from S. Line

\_\_\_\_\_ Ft. from E. Line

200 Ft. from W. Line

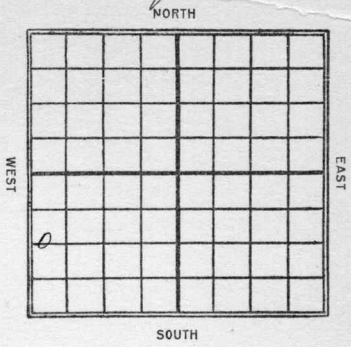

Date  
1922  
7/22

REPORT

Top Id 1675-1699 to  
40 qts 30 bbls

Map No. *Kans 17 21* Sec. *23* Twp. *13* R. *13*

Well No. *3 Jones*  
*R. G. Gillespie* Company

Contractor

FIRST REPORT

SECTION PLAT

**COMPLETED**


Ft. from N. Line

*1220* Ft. from S. Line

Ft. from E. Line

*200* Ft. from W. Line

Location

Rig up

Drilling and Remarks:

*Tap sand*  
*1675 to 1699 ft,*  
*40/30*

RECORD

Cased \_\_\_\_\_ in., \_\_\_\_\_ ft.

Sand \_\_\_\_\_

Gas \_\_\_\_\_

Oil \_\_\_\_\_

Total Depth \_\_\_\_\_

PRODUCTION

1st 24 hrs. Nat. \_\_\_\_\_

1st 24 hrs. after shot \_\_\_\_\_

Gas \_\_\_\_\_ Cu. Ft.

Dry Hole \_\_\_\_\_

Abandoned \_\_\_\_\_

Date

*JUL 22 1922*

*M. A. BENEAR*

191

Scout