
Sec. 21 Twp. 23S Rge. 13E
D+C Jones No.
Gillespie Company
Elev. T. D.
Log No. #2-3

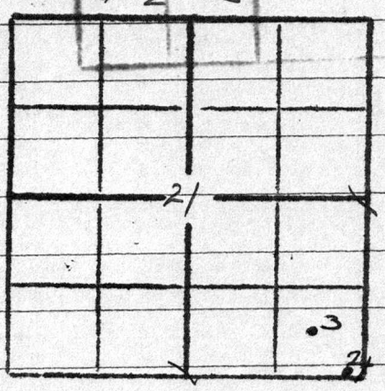

#2- N.R.

27032

#3 comm- 6-21-22
comp- 7-19-22

12" - 612
10 880
8 - 1312
6 - 1681

sand	0-5
sh	30
⌐	35
Blsh	200
sh	210
⌐	230
sh	240
⌐	260
sh	305
⌐	315
sh	334
⌐	345
sh	435
⌐	450
sh	580
⌐	585
sh	590
⌐	600
sh	605
⌐	615
sh	620
⌐	685
sh	695
⌐	805
S	825
⌐	855
RR	860
sh	880
⌐	885
sh	895
⌐	955
sh	960
⌐	965
sh	975
⌐	1015
sh	1145
⌐	1150
sh	1155
⌐	1165
mud	1185
⌐	1190
sh	1245
⌐	1255
Blsh	1275
⌐	1285
wtrs	1295
⌐	1300
sh	1315
⌐	1325
sh	1330
⌐	1340
sh	1681
⌐	1642
Shawnee	1692
D.	1765