
Form 51-10M-7-20-CroMac Kansas

Map No. ____ Sec. 21 Twp. 23 R. 13

Well No. 3 Jones Farm

Smith Okal Company

R G Gillespie

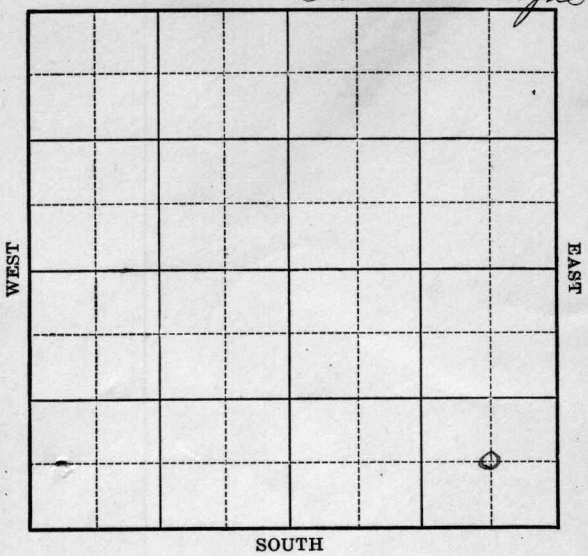

COMPLETED

Location _____

Drilling Remarks:

Rig Up _____

Drilling Remarks:

RECORD

Cased _____ in. _____ ft.

Sand _____

Gas _____

Oil _____

Total Depth _____

PRODUCTION

1st 24 hrs. Nat. _____

1st 24 hrs. after shot _____

Gas _____ cu. ft.

Dry Hole _____

Abandoned _____

Form 252A 5M 8-21 PALACE—TULSA 6835

Map No. _____ Sec. 21 Twp. 23 R. 13

Well No. #3 Jones Farm

Smith etal Company


R G Gillespie

_____ Ft. from N, Line

660 Ft. from S. Line

660 Ft. from E. Line

_____ Ft. from W. Line

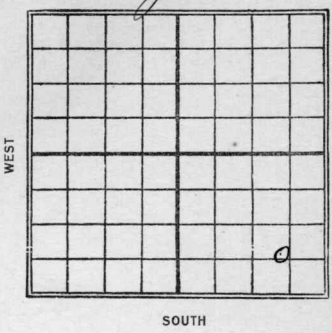

Date 1922	REPORT
7/15	Rig.
8/3	Td 1697-1765
	Top L 1681 Plug back to
	1721 Shot 60 qts
	5 Bbls

Form 26—1M—4-19—Mid-West

Map No. Bas 17 Sec. 21 Twp. 23 R. 13

Well No. 3 James

Smith et al Company

Contractor

FIRST REPORT


Ft. from N. Line

660 Ft. from S. Line

660 Ft. from E. Line

Ft. from W. Line

SECTION PLAT

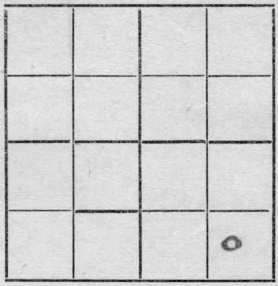

Location

Rig up

Drilling and Remarks:

Rig.

RECORD

Cased in., ft.

Sand

Gas

Oil

Total Depth

PRODUCTION

1st 24 hrs. Nat.

1st 24 hrs. after shot

Gas Cu. Ft.

Dry Hole

Abandoned

Date

JUL 15 1922 191

M. A. BENEAR Scout

Form 26—1M—4-19—Mid-West

Map No. Raw 7 Sec. 21 Twp. 23 R. 13


Well No. 3 Jones'

Smith Etal Company

R.G. Gillespie has taught Contractor

This ½ section, change name on map to R.G. Gillespie

SECTION PLAT

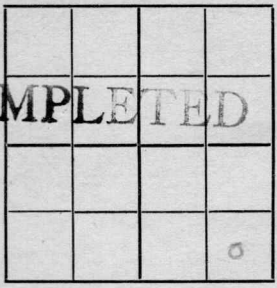

Ft. from N. Line

660 Ft. from S. Line

660 Ft. from E. Line

Ft. from W. Line

COMPLETED

Location

Rig up

Drilling and Remarks:

Tot L. 1681
Plug back
To 1721'
shot 60 qts.

RECORD

Cased in., ft.

Sand 1697 - 1765

Gas

Oil

Total Depth 1765

PRODUCTION

1st 24 hrs. Nat.

1st 24 hrs. after shot 5

Gas Cu. Ft.

Dry Hole

Abandoned

Date
AUG 13 1922

191

M. A. BENEAR Scout