



Butler

KANSAS


SEC.	TWP.	R.
17	27	6E

WELL NO. <sup>2</sup>  
#2 Getter FARM

COMPANY  
Beaumont Pet

CONTRACTOR  
Co. Tools  
Leoh

\_\_\_\_\_ Ft. from N. Line  
 \_\_\_\_\_ Ft. from S. Line  
 \_\_\_\_\_ Ft. from E. Line  
 \_\_\_\_\_ Ft. from W. Line

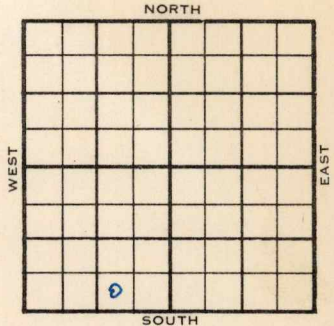

SW SE SW

	ELEVATION	REPORT
1955	1367'	
10/19	Comm 10-14-55 10" set Drlg 1920	
12-14	7" @ 2753/35 CO 6/ 2732-34 FU 400' wtr., sq. perf. CO 70/ 2718-26 viso-frac P/ 2 bopd Temp. Abd. KC 2125 BKC 2338 Marm 2433 Ce. 2540 Bart 2717 Miss. 2740 TD 2753'	

ABANDONED

County **Butler** Elev. \_\_\_\_\_  
 Sec. **17** Twp. **27** Rge. **6E**  
 Company **Beaumont Pet.**  
 Farm Name **Getter** No. **2**

TOPS	DEPTH	LOG	DATUM
Anh.			
Tp.			
H.			
Tr.			
Dg.			
B.L.			
L.			
K.C.			
B.K.C.			
Ce.			
C.			
M.			
M.			
K.			
Mz.			
Me.			
V.			
S.			
S.			
A.			
R.			
Pe.			
G.			
T.D.			

Loc. in Sec. **SW SE SW**

Geol. \_\_\_\_\_

Contr. **Co. tools**

Pool **Leon**

<b>FIRST REPORT</b>		
<b>OCT</b>	<b>9</b>	<b>1955</b>
0		

Date Comm. **10-14-55**  
**10" set d rlg. 1920**

Co.  
Lse.  
No.  
Sec.  
T.  
R.

County Butler Elev. 1367  
 Sec. 17 Twp. 27 Rge. 6E  
 Company Beaumont Pet.  
 Farm Name Getter No. 2

TOPS	DEPTH	LOG	DATUM
Anh.			
T.P.			
H.			
Tr.			
Dg.			
Bl.			
L.			
K.C.	<u>2125</u>		<u>758</u>
B.K.C.	<u>2338</u>		<u>971</u>
Ce. <u>manu</u>	<u>2433</u>		<u>1066</u>
C. <u>ce</u>	<u>2540</u>		<u>1173</u>
M. <u>Bart</u>	<u>2717</u>		<u>1350</u>
M. <u>in</u>	<u>2740</u>		<u>1373</u>
K.			
Mz.			
Mq.			
V.			
S.			
S.			
A.			
R.			
Pe.			
G.			
T.D.	<u>2753</u>		

Loc. in Sec. SW SE SW  
 Geol. \_\_\_\_\_  
 Contr. Co. tools  
 Pool Leon

ABANDONED		
-----------	--	--

Date Comm. 10-14-55 DEC 14 1955  
 10" @ 7" @ 2753/35 CO 6/ 2732-34  
 FU 400' wtr. sq. perf. CO  
 70/ 2718-26 viso-frac P/ 2 bopd  
 Temp. abd.

Co.  
Lse.  
No.  
Sec.  
T.  
R.