


Kansas

Map No. _____ Sec. 21 Twp. 23 R. 13

Well No. 4 Jones Farm
R. Y. Gillespie Company

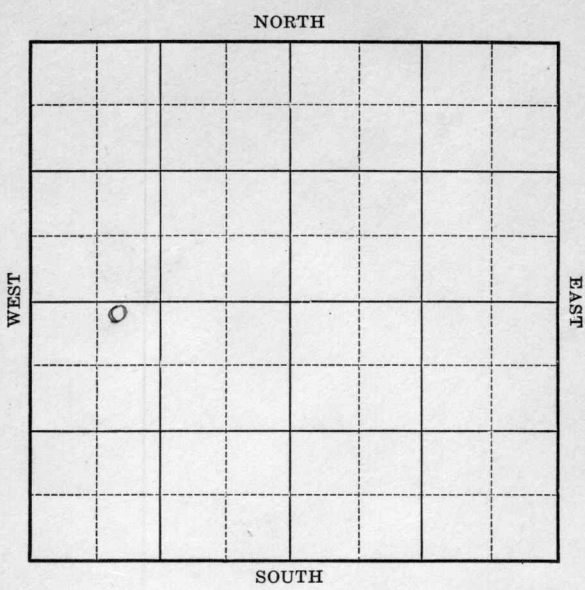

Location _____

Drilling Remarks:

RECORD

Cased _____ in. _____ ft.

Sand _____

Gas _____

Oil _____

Total Depth _____

Rig Up _____

Drilling Remarks:

PRODUCTION

1st 24 hrs. Nat. _____

1st 24 hrs. after shot _____

Gas _____ cu. ft.

Dry Hole _____

Abandoned _____

Map No. K17 Sec. 21 Twp. 23 R. 13

Well No. 4 - Jones

R. G. Gillespie Company

Contractor

FIRST REPORT

SECTION PLAT

200 Ft. from N. Line

----- Ft. from S. Line

----- Ft. from E. Line

760 Ft. from W. Line

o		o	

Location -----

Rig up -----

Drilling and Remarks:

Rig.

RECORD

Cased ----- in., ----- ft.

Sand -----

Gas -----

Oil -----

Total Depth -----

PRODUCTION

1st 24 hrs. Nat. -----

1st 24 hrs. after shot -----

Gas ----- Cu. Ft.

Dry Hole -----

Abandoned -----

Date

JUL 27 1922

M. A. BENEAR

191

Scout

Map No. **KANSAS** 17 Sec. 21 Twp. 23 R. 13

Well No. *H Jones*

R. G. Pillsbury Company

Contractor

COMPLETED SECTION PLAT

200 Ft. from N. Line

----- Ft. from S. Line

----- Ft. from E. Line

1120 Ft. from W. Line

o			

Location -----

Rig up -----

Drilling and Remarks:

Pay 1688-1700

T.D. 1702

*shot 40 lbs
25 lbs!*

RECORD

Cased ----- in., ----- ft.

Sand -----

Gas -----

Oil -----

Total Depth -----

PRODUCTION

1st 24 hrs. Nat. -----

1st 24 hrs. after shot -----

Gas ----- Cu. Ft.

Dry Hole -----

Abandoned -----

Date

JAN 6 1923

M. A. BENEAR

----- 191 -----

Scout