


Section 17 Township 27 Range 6-E

Well Number 2 Getter

Company Richmond Drlg.

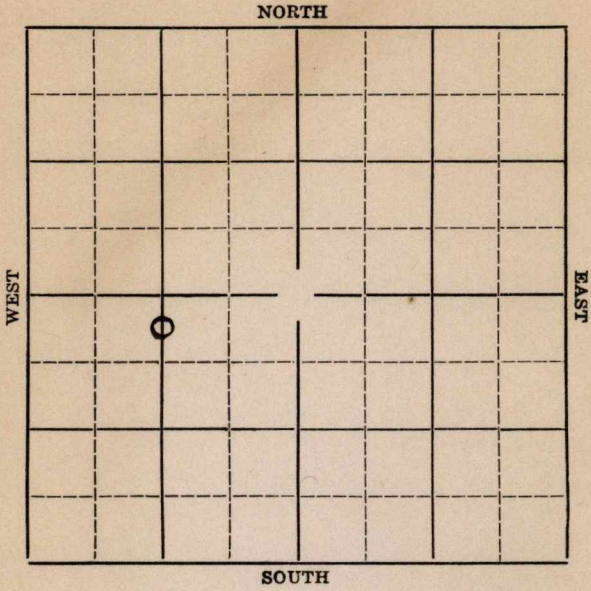

Sec. 17 Twp. 27 R. 6-E


Well No. #2 Getter Farm
Richmand Drlg. Company

330 Ft. from N. Line

_____ Ft. from S. Line

_____ Ft. from E. Line

1320 Ft. from W. Line

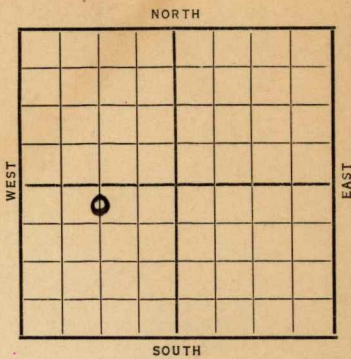

Elev. 1374

Date	REPORT
1937	
3/10	12" @ 700'. Drlg. 720'.
3/18	" " " " "
3/25	KCL 1820'. Drlg. 2005'.
4/2	8" @ 2410'. Drlg. 2555'.
4/8	Bart S 2700-35' Mississippi 2745' Drlg. 2755'
4/16	T.D. 2755'. Shot 40 qts, swabb 35 bbls. a day.
4/23	" " " "
4/30	T.D. 2755'. Rng. tubing.
5/5	Miss. 2745'.
	T.D. 2755'.
	Shot 40 qts. 2729-38'.
	Pot. 45.
	COMPLETED

KANSAS

Map No. 11 Sec. 17 Twp. 27 R. 6E

Well No. 2 Getter

Richmond Drlg. Company

Contractor

SECTION PLAT

	0		

830 Ft. from N. Line

_____ Ft. from S. Line

_____ Ft. from E. Line

1320 Ft. from W. Line

FIRST REPORT

Location _____

Rig up _____

Drilling and Remarks:

12" @ 700
Drlg 720

RECORD

Cased _____ in., _____ ft.

Sand _____

Gas _____

Oil _____

Total Depth _____

PRODUCTION

1st 24 hrs. Nat. _____

1st 24 hrs. after shot _____

Gas _____ Cu. Ft.

Dry Hole _____

Abandoned _____

Date

MAR 10 1937

19

S. J. LEWIS

Scout

Butler KANSAS

Map No. 11 Sec. 17 Twp. 27 R. 6E

Well No. 2-Getter

Richmond Drilling Company
Contractor

COMPLETED

SECTION PLAT

330 Ft. from N. Line

_____ Ft. from S. Line

_____ Ft. from E. Line

1320 Ft. from W. Line

0			

Location _____

Rig up _____

Drilling and Remarks:

Shot w/40 gts
2729-38

pot. 45

RECORD

Cased _____ in., _____ ft.

Sand MISS. - 2745

Gas _____

Oil _____

Total Depth 2755

PRODUCTION

1st 24 hrs. Nat. _____

1st 24 hrs. after shot _____

Gas _____ Cu. Ft.

Dry Hole _____

Abandoned _____

Date

MAY 5 - 1937

19

H. D. Hatfield Subst